

BATCH ID 165G

GEODETTIC SURVEY OF N.S.W.

LAND INFORMATION CENTRE

GEODETTIC STATION RECONNAISSANCE and MAINTENANCE REPORT

STATION: **SALLY (P)** No.: **7396**
 MAP SHEET SCALE 1:250 000 **CANBERRA**
 INSPECTED BY: **G. FORD** DATE: **23-9-94**
 AUTHORITY: **L. I. C.** FIELD BOOK: **647**

Description: *Note: Cross out word or words which do not apply*

1. Cleared by vanes bearing **332° - 322° M (ONE TRIG AT 325°)** **Good G.P.S. TRIG** from Trig. Mast

2. Mast & Vanes have been painted white & black respectively. ✓

3. The station/pillar was ~~unplaced/not unplaced~~/constructed on **23 - 9 - 1994**, dimensions now being:

Description of mark: ~~STEEL PILLAR PLATE~~ should be explicit, e.g. S/Steel Pillar Plate, ~~Steel plug/Bronze plug/Bolt/G.I. Pipe~~

Height of mark: **1.365** ^{above} ~~below~~ **Reek/concrete**; Mark is **1.505** ^{above} ~~below~~ **G.L.**

Height of Top Vanes to Top ~~Mark~~/Pillar plate **1.440** ^{above} ~~below~~ **m**. Diameter of Vanes (vertical) **0.250** ^{above} ~~below~~ **m**.

Height of Cairn.....m. Diameter of Cairn.....m. Name Plate found/not found/placed.

Length of Mast.....m. (approximate if not unplied)

4. **A. BRASS TRIG. PLUG**..... set in ~~stone~~/rock has been ~~placed~~/found, bearing **284°** M from ~~Mast~~/Plug/Pillar

5. **A. G.I. PIPE**..... set in ~~conc/rock~~ has been ~~placed~~/found, bearing **337°** M from ~~Mast~~/Plug/Pillar

6. **A.**..... set in ~~conc/rock~~ has been placed/found, bearing.....° M from Mast/Plug/Pillar

7. **A.**..... set in ~~conc/rock~~ has been placed/found, bearing.....° M from Mast/Plug/Pillar


8. Action required:.....

STANDPOINT: CONC PILLAR		STANDPOINT: BRASS TRIG PLUG					
Mark	Direction	Horiz. Distance	Height Difference	Mark	Direction	Horiz. Distance	Height Difference
WOOLWOLAR (P)	0 00 00		^{above} standpt.	WOOLWOLAR (P)	0 00 00		^{above} standpt.
PYRRORUMBA (P)	122 49 40		^{above} standpt.	PYRRORUMBA (P)	122 49 40		^{above} standpt.
GROSES HILL (GS)	147 08 10		^{above} standpt.	GROSES HILL (GS)	147 08 20		^{above} standpt.
TRIG PLUG	170 25 30	2.463	^{above} standpt.	G.I. PIPE	280 31 10	2.400	^{above} standpt.
G.I. PIPE	224 23 20	2.790	^{above} standpt.	CONC PILLAR	350 24 40	2.465	^{above} standpt.
			^{above} standpt.				^{above} standpt.
			^{below} standpt.				^{below} standpt.
			^{below} standpt.				^{below} standpt.

Prepared by: **G. Ford** 30/9/94

Checked: **Checked**

Noted on U.T.M. Card

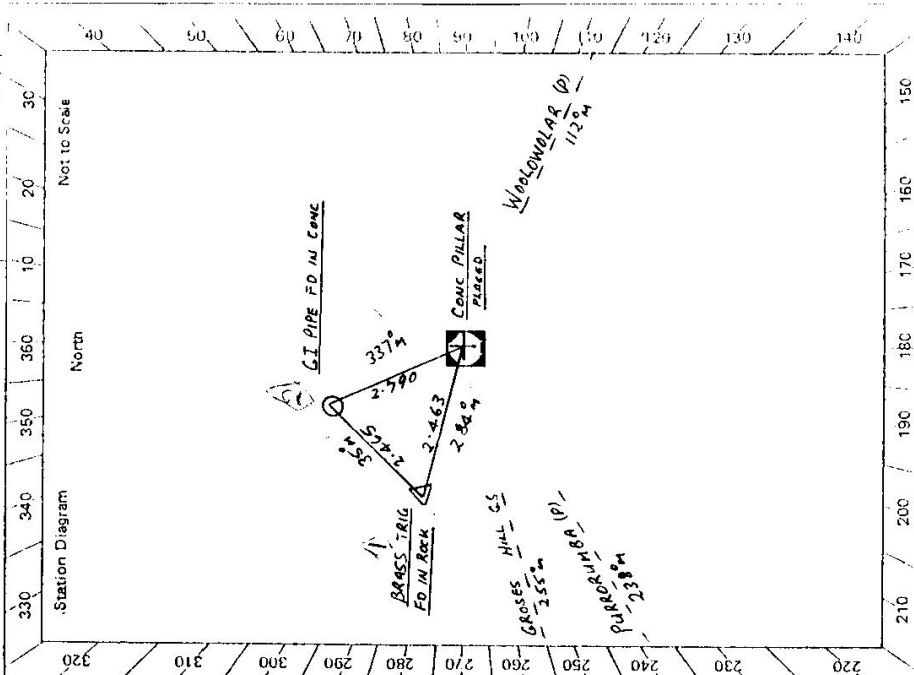

STATION **SALLY (P) TS 7396**

Owner's Name: **DAVID ROCKLEY**
 Current Occupant: **STATION IS A CURRENT TR 11924**

Address: **"PYLARA"**

VIA **TARAGO**

Phone: **(048) 494 955**


MOBL **(018) 678913**

(018) 482418

Access Report of **23/9/1994** was found suitable/unsuitable.

ACCESS

- 0-00 INTERSECTION AT TARAGO VILLAGE
 SIGN POSTED GOULBURN - BRAIDWOOD BUNCELDRE QUEANBEYAN - BUNGONIA
 TAKE ROAD TOWARDS BUNCELDRE - QUEANBEYAN (WALLACE ST)
 THE LOADED DOC HOTEL ON LEFT
- 0-8 PASS POLICE STATION ON LEFT & CROSS RAILWAY LINE ✓
- 2-6 CROSS BRIDGE "CRISPS CREEK"
- 4-6 TURN RIGHT SIGN WOODLAWN MINE & CURRAWANG 18 COLLECTOR 32
 GOULBURN 42 CANBERRA 71
- 6-0 PASS DRIVE WAY
- 6-1 TURN LEFT ACROSS GRID "PYLARA"
- 6-2 TURN LEFT THEN FOLLOW TRACK AROUND TO RIGHT (OWNER'S HOUSE TO RIGHT)
- 6-7 IRON GATE BEFORE HOUSE & SHEDS
- 6-8 PASS SHEDS ON R.H.S. FOLLOW MAIN TRACK AROUND TO RIGHT
- 6-9 DOUBLE IRON GATES " " "
- 8-1 TAKE MAIN TRACK TO RIGHT DOUBLE IRON GATES
- 9-1 DOUBLE IRON GATES
- 10-0 TAKE SECOND GATE ON RIGHT JUST BEFORE DOUBLE IRON GATES FOLLOW FANOT.
 TRACK ALONG FENCE
- 10-1 VEER LEFT FOLLOWING FAINT TRACK TOWARDS TRIG HILL
- 10-2 IRON GATE FOLLOW OLD DORSET TRACK TO LEFT TO TOP OF HILL
- 11-3 SALLY G.S. (P)

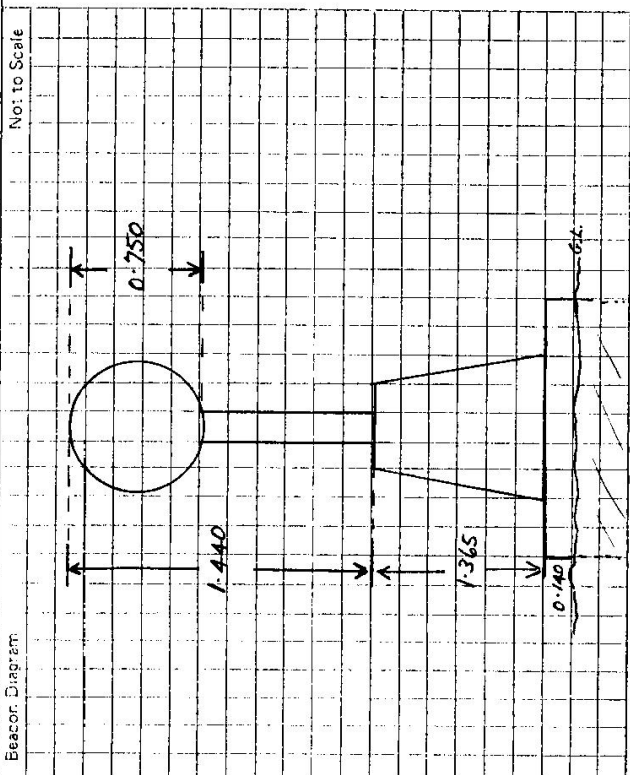

This section to be completed by officer constructing pillar.

Original station mark found/not found: **B.RASS TRIG. PLUG IN ROCK.....**

Description of mark: **CAIRN MAST & VANES**

Original beacon found/not found: **3.420**

Description of beacon: **above rock/above AT**

Height of Top of Vanes to Top Mark: **1.00** above G.L. below

Height of mark: **1.00** above G.L. below

Diameter of Vanes: **1.00** m. Height of Cairn: **1.2** m.

Original Beacon has/has not been destroyed by me.