

GEODETTIC SURVEY OF N.S.W.

CENTRAL MAPPING AUTHORITY

GEODETTIC STATION RECONNAISSANCE and MAINTENANCE REPORT

Description:

- Note: Cross out word or words which do not apply*
1. Cleared by James bearing..... 240-270 m. ~~two trees~~ // 230-240 Thick medium timber..... from Trig. Mast
  2. Mast & Vanes have been painted white & black respectively. ~~no beacon~~
  3. The station/pillar was unpiled/not unpiled/constructed on..... 19....., dimensions now being:  
Description of mark..... should be explicit, e.g., S/Steel Pillar Plate, Steel plug, Brass plug, Bolt, G.I. Pipe  
Height of mark..... m. <sup>above</sup> rock/concrete; Mark is..... m. <sup>above</sup> <sub>below</sub> G.L.
  - Height of Top Vanes to Top Mark/Pillar plate..... m. Diameter of Vanes (vertical)..... m.
  - Height of Cairn..... m. Diameter of Cairn..... m. Name Plate found/not found/placed.
  - Length of Mast..... m (approximate if not unpiled)
  4. A..... set in conc/rock has been placed/found, bearing..... ° M from Mast/Plug/Pillar
  5. A..... set in conc/rock has been placed/found, bearing..... ° M from Mast/Plug/Pillar
  6. A..... set in conc/rock has been placed/found, bearing..... ° M from Mast/Plug/Pillar
  7. A..... set in conc/rock has been placed/found, bearing..... ° M from Mast/Plug/Pillar
  8. Action required:..... **GOVERN**.....  
1:25,000

STANDPOINT:

Mark	Direction	Horiz. Distance	Height Difference	Mark	Direction	Horiz. Distance	Height Difference
			above standpt.				above standpt.
			below				below
			above standpt.				above standpt.
			below				below
Prepared by: *[Signature]*

Checked:

Noted on U.T.M. Card

SI 2735-1

STATION: <b>RDSSI</b>	No.: <b>3955</b>
MAP SHEET SCALE 1:250 000	<b>Goulburn</b>
INSPECTED BY: <b>A. Sivertsen</b>	DATE: <b>16-10-78</b>
AUTHORITY: <b>CMA</b>	FIELD BOOK: <b>1642</b>

North  
Not to Scale

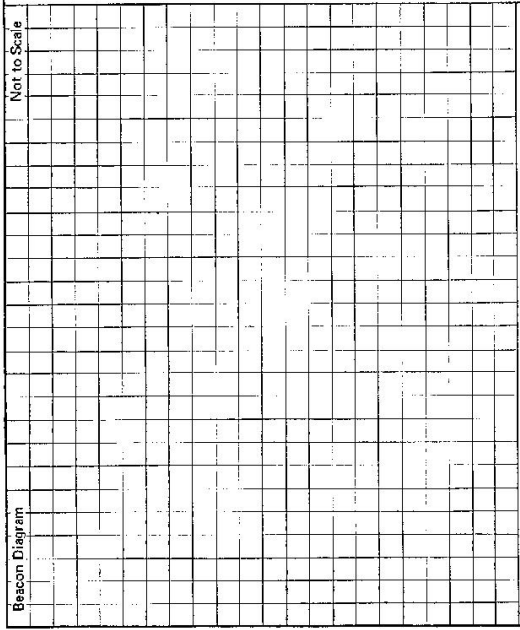
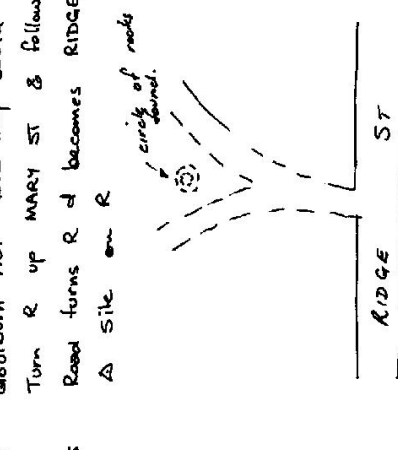
△ was NOT found.  
↳ a circle of white painted rocks found on highest point of hill

1975 Reservoir site seems to have been abandoned

- too timbered for resection but site does not compare favourably with Gray △  
+  
- Poor △ site

**Recomm. For RESECTION**

GS

Et 2733-2 D. West, Government Printer Beacon Diagram	Not to Scale 	STATION <b>ROSS1</b> <b>TS 3955</b>	<p>Owner's Name: <b>Goulburn Shire Council</b>                  Address: .....                  Phone: .....</p> <p>Current Occupant: .....                  Address: .....                  Phone: .....</p> <p style="text-align: center;"><u>ACCESS</u></p> <p>Access Report of <b>R/18/1928</b> was found suitable/unavailable.</p> <p><b>0.0</b> Goulburn P.O. Take Hwy south  <b>1.8</b> Turn R up MARY ST &amp; follow through to end.  <b>3.55</b> Road turns R &amp; becomes RIDGE ST  <b>4.0</b> A site on R</p> <div style="text-align: center;">  <p style="font-size: small;">circle of nodes found.</p> </div>
			Date Record of Station
			This section to be completed by officer constructing pillar. Original station mark found/not found. Description of mark: ..... Original beacon found/not found. Description of beacon: ..... Height Top of Vanes to Top Mark .....m. Height of mark .....m.      above G.L. / below Diameter of Vanes .....m.      Height of Cairn .....m. Original Beacon has/has not been destroyed by me.

LAND INFORMATION CENTRE

GEODETIC SURVEY OF A.S.W.

GEODETIC STATION RECONNAISSANCE and MAINTENANCE REPORT

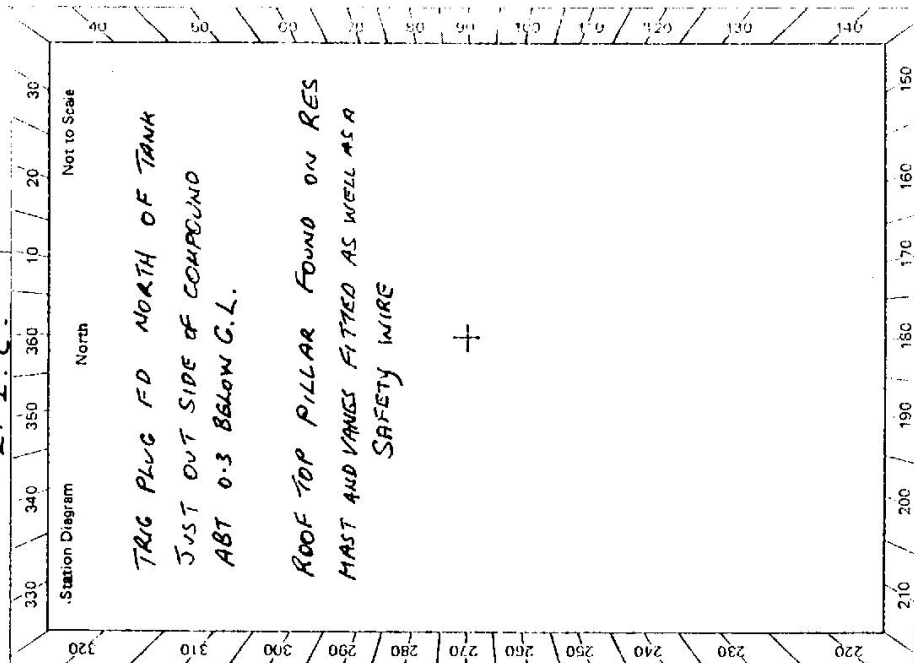
STATION: **ROSSI** No.: **7400**  
 MAP SHEET SCALE 1:250 000  
 INSPECTED BY: **G. FORD** DATE: **1-3-95**  
 AUTHORITY: **L. I. C.** FIELD BOOK: **—**

Description:  
 1. Cleared by vanes bearing **360°** *Note: Cross out word or words which do not apply*  
**GOOD G.P.S.** from Trig. Mast  
 2. Mast & Vanes have been painted white & black respectively. ✓  
 3. The station/pillar was unpiled/not unpiled/constructed of..... 19....., dimensions now being:

Description of mark: **ROOF TOP PILLAR** should be explicit, e.g., S/Steel Pillar Plate, Steel plug, Brass plug, Bolt, G.I. Pipe  
 Height of mark.....m. <sup>above</sup> rock/concrete; Mark is.....m. <sup>above</sup> G.L.  
 Height of Top Vanes to Top Mark/Pillar plate **1.435** m. Diameter of Vanes (vertical) **0.750** m.  
**HEIGHT OF PILLAR 1.440 ABOVE PLATFORM OF TANK.**  
 Height of Cairn.....m. Diameter of Cairn.....m. Name Plate found/not found/placed.

Length of Mast.....m. (approximate if not unpiled)  
 4. A.....set in conc/rock has been placed/found, bearing.....° M from Mast/Plug/Pillar  
 5. A.....set in conc/rock has been placed/found, bearing.....° M from Mast/Plug/Pillar  
 6. A.....set in conc/rock has been placed/found, bearing.....° M from Mast/Plug/Pillar  
 7. A.....set in conc/rock has been placed/found, bearing.....° M from Mast/Plug/Pillar  
 8. Action required:.....

STANDPOINT:				STANDPOINT:			
Mark	Direction	Horiz. Distance	Height Difference	Mark	Direction	Horiz. Distance	Height Difference
			above standpt				above standpt
			below				below
			above standpt				above standpt
			below				below
Prepared by: **S. Ford** 6/3/95  
 Checked: **Noted on U.T.M. Card**  
 S12733-1

7400

ROSSI ROOF TOP PILLAR

FEB 1995

STATION

2735-2 D. West. Government Printer

Beacon Diagram

No. to Scale

LOCKED GATE

Owner's Name: GOULBURN CITY COUNCIL  
 Address: ENG DEF  
 Phone: MR BOB MCDONALD  
 OR MR TIM COGAN  
 WATER/SEWER OVERSEER  
 Access Report of ..... was found suitable/unsuitable.  
 ACCESS

Current Occupant:  
 Address:  
 Phone:

- 0.00 P.O. GOULBURN HEAD SOUTH
- 0.35 TURN RIGHT INTO CLINTON ST
- 0.8 CROSS COWPER ST
- 1.5 TURN LEFT INTO DECCAN ST
- 1.8 TURN RIGHT INTO ADDISON ST
- 3.1 TURN LEFT INTO RIDGE ST
- 3.6 RES ON YOUR LEFT

KEY NO 62 REQUIRED  
 GOULBURN CITY COUNCIL.

This section to be completed by officer constructing pillar.

Original station mark found/not found.

Description of mark: .....

Original beacon found/not found.

Description of beacon: .....

Height Top of Vanes to Top Mark ..... m.

Height of mark ..... m. above below G.L.

Diameter of Vanes ..... m. Height of Cairn ..... m.

Original Beacon has/has not been destroyed by me.

Date	Record of Station