
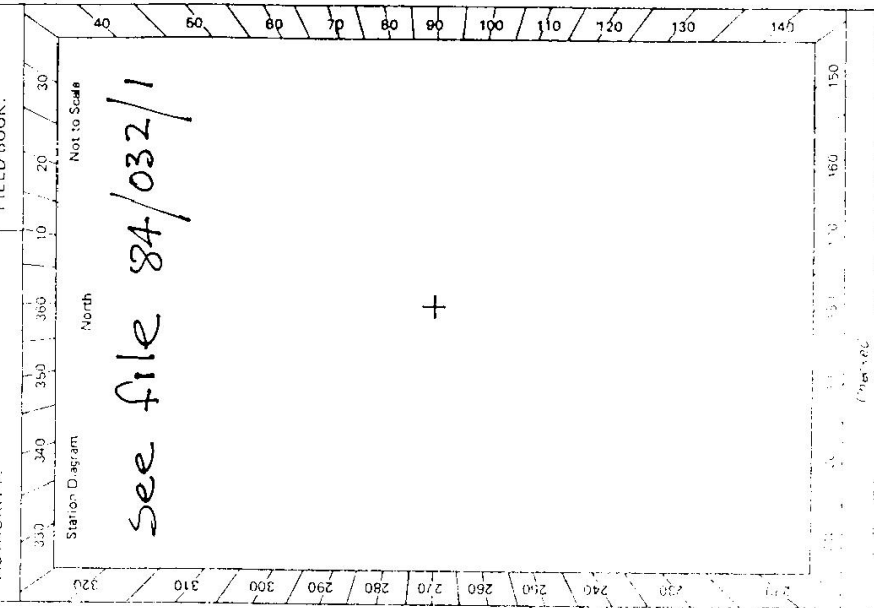


CENTRAL MAPPING AUTHORITY
 GEODETIC SURVEY OF N.S.W.
 GEODETIC STATION RECONNAISSANCE and MAINTENANCE REPORT

STATION: RICHMOND No 1	Case No: TS 780
MAP SHEETS SCALE 1:250 000	SCALE 1:100 000
INSPECTED BY:	DATE:
AUTHORITY:	FIELD BOOK:

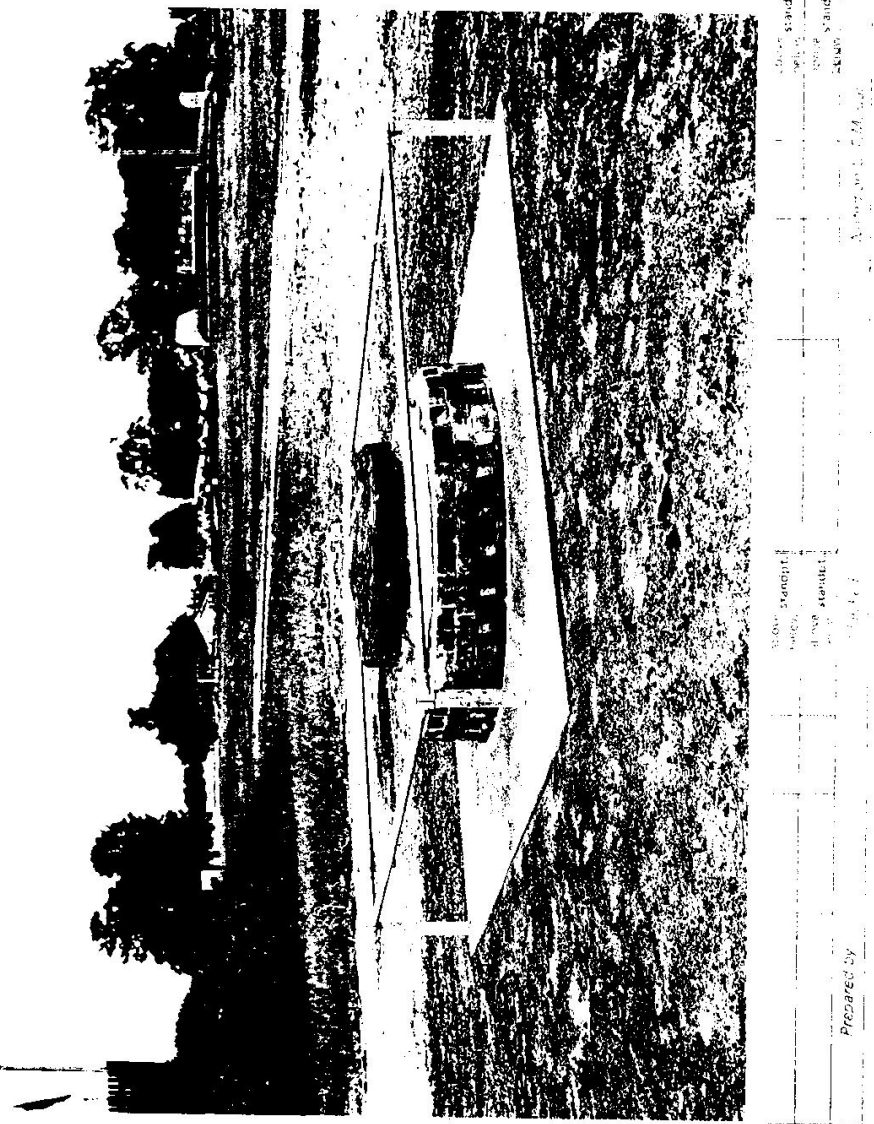

Prepared by


31/05/2022

CENTRAL MAPPING AUTHORITY

GEODETIC SURVEY OF N.S.W.

GEODETIC STATION RECONNAISSANCE and MAINTENANCE REPORT

STATION
S 1111

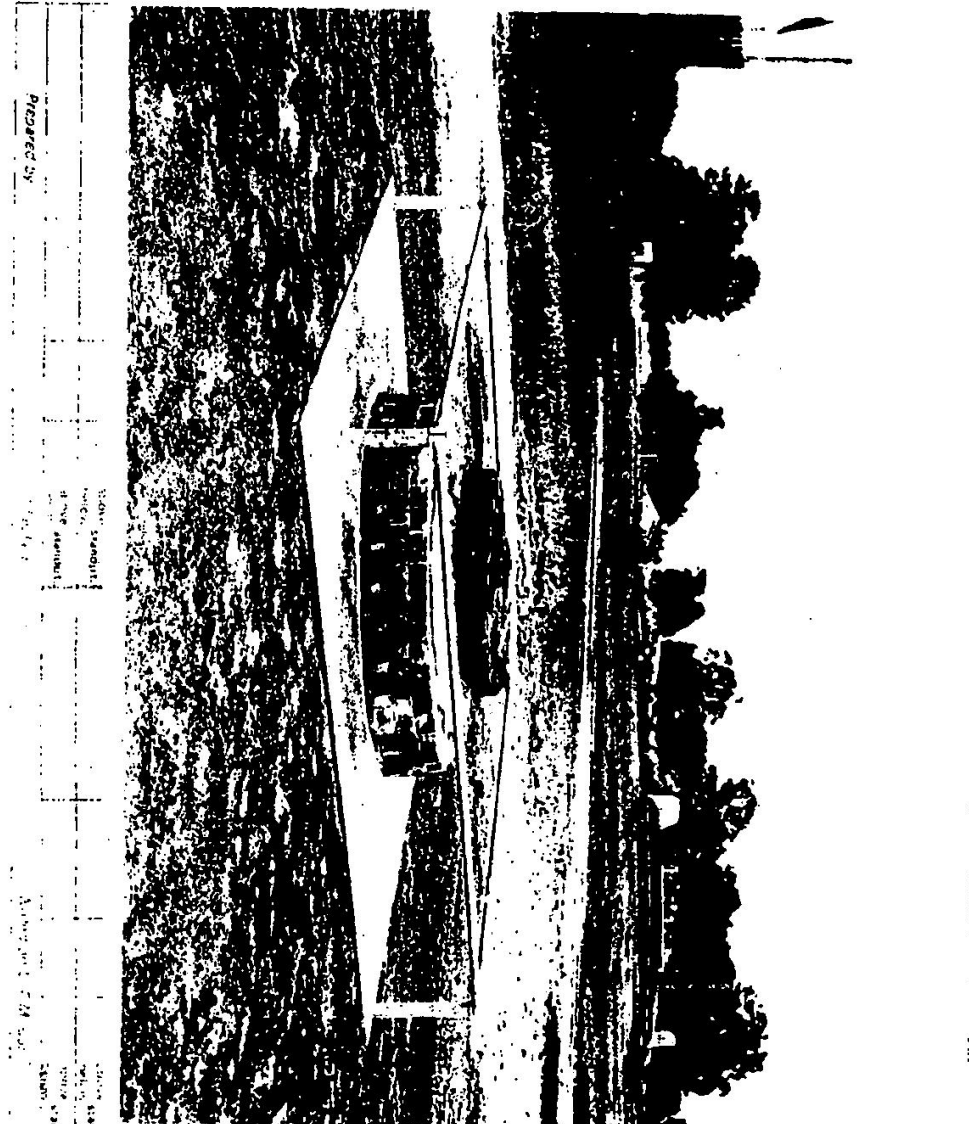

STATION: RICHMOND	Case No: TS 780
MAP SHEETS	SCALE 1:100 000
INSPECTED BY:	DATE:
AUTHORITY:	FIELD BOOK:

Station Diagram	North	Not to Scale
<p>see file 84/032/1</p> <p style="font-size: 2em;">+</p>		

Station Diagram: 320, 310, 300, 290, 280, 270, 260, 250, 240, 230, 220, 210, 200, 190, 180, 170, 160, 150, 140

Station: 320, 310, 300, 290, 280, 270, 260, 250, 240, 230, 220, 210, 200, 190, 180, 170, 160, 150, 140

CENTRAL MAPPING AUTHORITY

GEODETIC SURV. OF N.S.W.

GEODETIC STATION RECONNAISSANCE and MAINTENANCE REPORT

STATION: **RICHMOND** / **101** / **Case No. TS 780**



MAP SHEETS
SCALE 1:250,000

INSPECTED BY:

DATE:

AUTHORITY:

FIELD BOOK:

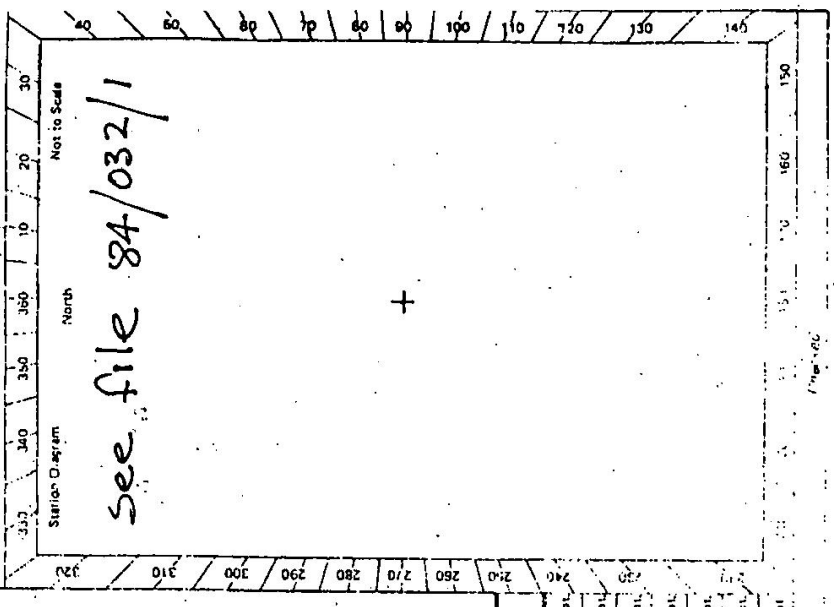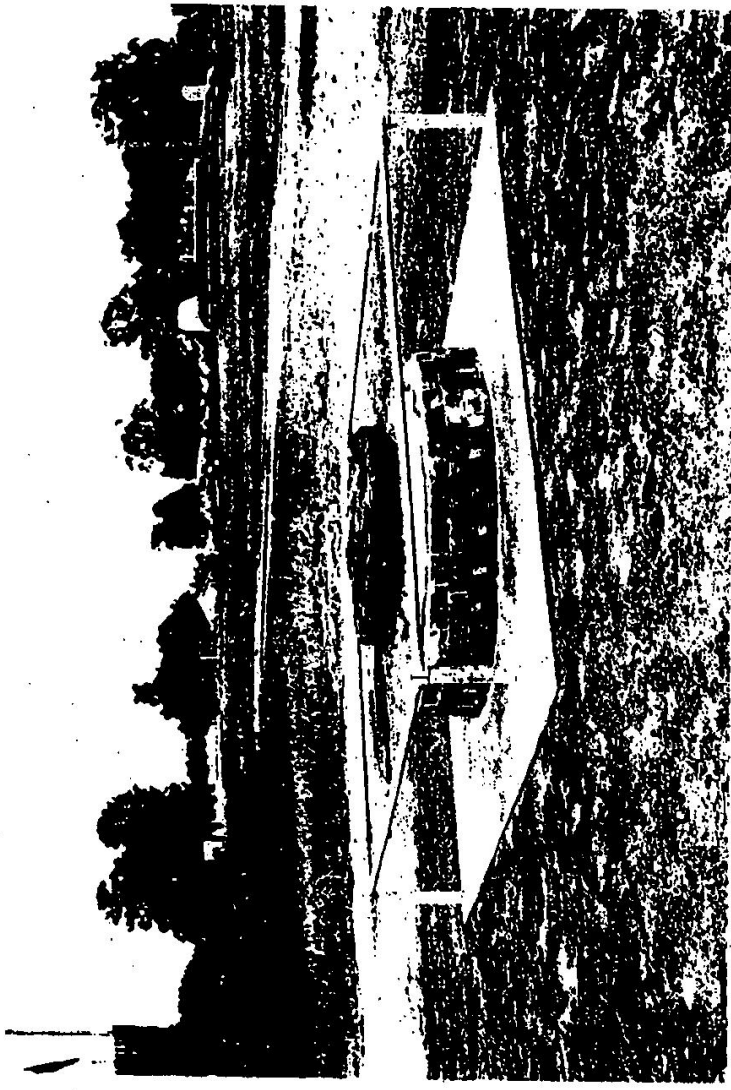

Prepared by

Checked by

Drawn by

Scale

Projection

Map Sheet

Station No.

Station Name

Station Description

Station Coordinates

Station Elevation

Station Accuracy

Station Status

Station Date

Station Notes