

GEODETTIC SURVEY OF N.S.W.

CENTRAL MAPPING AUTHORITY

GEODETTIC STATION RECONNAISSANCE and MAINTENANCE REPORT

Description:

1. Cleared by lanes bearing.....
 Note: Cross out word or words which do not apply
 from Trig, Mast.

2. Mast & Vanes have been painted white & black respectively.

3. The station/pillar was unpiled/not unpiled/constructed on.....19....., dimensions now being:

Description of mark.....should be explicit, e.g., S/Steel Pillar Plate, Steel plug, Brass plug, Bolt, G.I. Pipe

Height of mark.....m. ^{above}/_{below} rock/concrete; Mark is.....m. ^{above}/_{below} G.L.

Height of Top Vanes to Top Mark/Pillar plate.....m. ^{0.60 top} Diameter of Vanes (vertical).....m.

Height of Cairn.....m. ^{1.30} Diameter of Cairn.....m. Name Plate ~~found~~/not found/~~placed~~.

Length of Mast.....m. ^{3.13} (approximate if not unpiled)

4. A.....set in conc/rock has been placed/~~found~~, bearing.....°M from Mast/Plug/Pillar

5. A.....set in conc/rock has been placed/~~found~~, bearing.....°M from Mast/Plug/Pillar

6. A.....set in conc/rock has been placed/~~found~~, bearing.....°M from Mast/Plug/Pillar

7. A.....set in conc/rock has been placed/~~found~~, bearing.....°M from Mast/Plug/Pillar

8. Action required:.....

STANDPOINT:

Mark	Direction	Horiz. Distance	Height Difference	Mark	Direction	Horiz. Distance	Height Difference
			above standpt				below standpt
			below standpt				above standpt
			above standpt				below standpt
			below standpt				above standpt
			above standpt				below standpt
			below standpt				above standpt
			above standpt				below standpt
			below standpt				above standpt

Prepared by: *[Signature]* 15/11/78

Checked:

Noted on U.T.M. Card

Checked

STATION: Beck No.: 803
 MAP SHEET SCALE 1:250 000 NOLLONGONG
 INSPECTED BY: M.L. Morrison DATE: 20/10/78
 AUTHORITY: C.M.A. FIELD BOOK: 1710

Station Diagram
 North
 330 340 350 360 370 380 390
 220 230 240 250 260 270 280 290 300 310 320
 140 150 160 170 180 190 200 210 220

Trig set in fair condition, needs painting. Abt 1 to 2 days clearing required for 300' vision
 Abt to Mt Clive timbered ridge blocking vision
 Clear vision SE to Mt. except for close ridge Abt N.S.W. Mt.

+

STATION BECK G.S. - 803

Owner's Name:
 Address:
 Phone:
 Current Occupant:
 Address:
 Phone:

ACCESS

Access Report of 29/10/1978 was found suitable/unsuitable.

Direction

Km

0.00 At Intersection near Tennis Courts in Bungonia take road to Bungonia Lookdown 11'

6.05 GRID

6.85 Turn right onto track on R.H.S. of Shed.

7.25 Gate follow straight ahead


7.55 Pass track on your right

7.75 Pass large dam on your right.

8.65 Go straight ahead through gate

8.90 Park truck. Trig Sains easy walk out spur on R.H.S. of track. Fence could be chopped and Trig could be driven to along old track.

Date	Record of Station

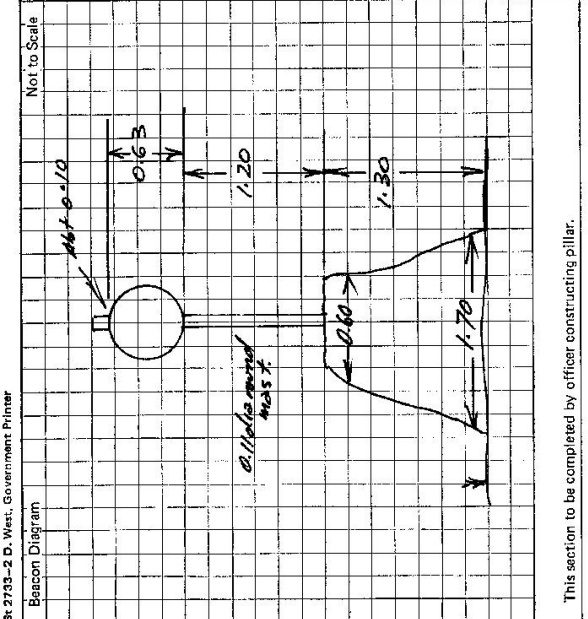

This section to be completed by officer constructing pillar.

Original station mark found/not found.

Description of mark:

Original beacon found/not found.

Description of beacon:

Height Top of Vanes to Top Mark.....m.

Height of mark.....m. above G.L. below

Diameter of Vanesm. Height of Cairnm.

Original Beacon has/has not been destroyed by me.