



STATION BEECLOFT PILLAR TS 812


Current Occupant.....

Address.....

Owners Name.....

Address.....

Access 16-7-1975

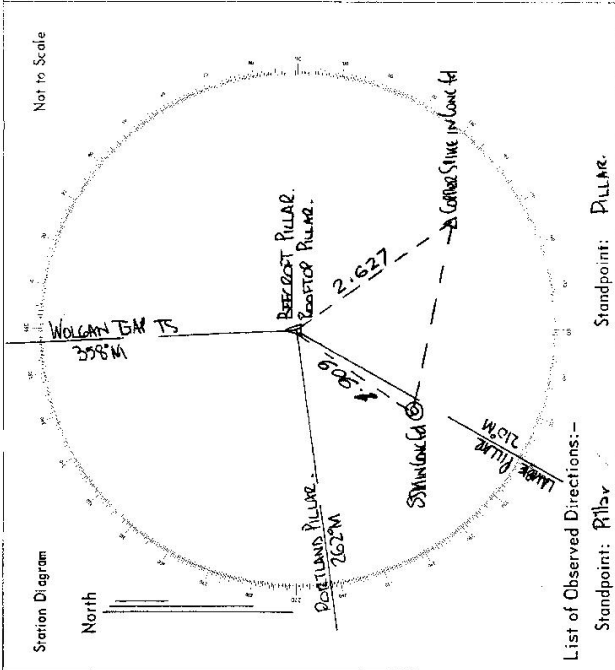

List of Observed Directions:-

Standpoint: Pillar

Standpoint: PILLAR

Station	Direction	Station	Direction
LAMBE PILLAR	359 55 00	LAMBE PILLAR	359 55 00
PORTLAND PILLAR	66 22 043	PORTLAND PILLAR	66 22 043
WOLGAN ISM TS	17 592	WOLGAN ISM TS	17 592
		CONCRETE IN LANE 4	281 35 015

