

Department of Lands
 Integral
 RECONNAISSANCE
 MAINTENANCE REPORT
 No. 815

SEE ALSO MINISTRIAL RES.
 No. 815
 CUMBERLAND
 THE HUNTERS HILL

Map Sheet:
 Inspected by:
 Authority:
 Date:
 Field Book:
 No.:

This Trig. Station has been:-

Note: Cross not used in this report, which does not apply

1. Completely cleared to permit 360° vision to surrounding Trigs.
2. Cleared by lanes bearing from Trig. Mast
3. Trig. Mast & Vanes have been painted white & black respectively.
4. The Trig. was unpiled/not unpiled, dimensions now being:

Description of mark..... should be explicit, e.g. Steel plug, Brass plug, Bolt, Concrete Pillar

Height of mark..... m above below rock/concrete m above below G.L.

Height of Top Vanes to Top Mark/Top pillar plate..... m Diameter of Vanes (vertical)..... m.

Height of Cairn..... m. Diameter of Cairn..... m.

Length of Mast..... m. (approximate if not unpiled)

5. A..... set in conc/rock has been placed/fd..... m. bearing..... °M from Trig. Mast/pillar
6. A..... set in conc/soil has been placed/fd..... m. bearing..... °M from Trig. Mast/pillar
7. A..... set in conc/soil has been placed/fd..... m. bearing..... °M from Trig. Mast/pillar
8. A..... set in conc/rock has been placed/fd..... m. bearing..... °M from Trig. Mast/pillar

9. Connection..... to..... m. bearing..... °M

10. Connection..... to..... m. bearing..... °M

11. Connection..... to..... m. bearing..... °M

12. Connection..... to..... m. bearing..... °M

13. Diff. Ht. is..... m. above below

14. Diff. Ht. is..... m. above below


15. Diff. Ht. is..... m. above below

16. Diff. Ht. is..... m. above below


Prepared By:..... Checked:.....

Date	Record of Station

Not to Scale

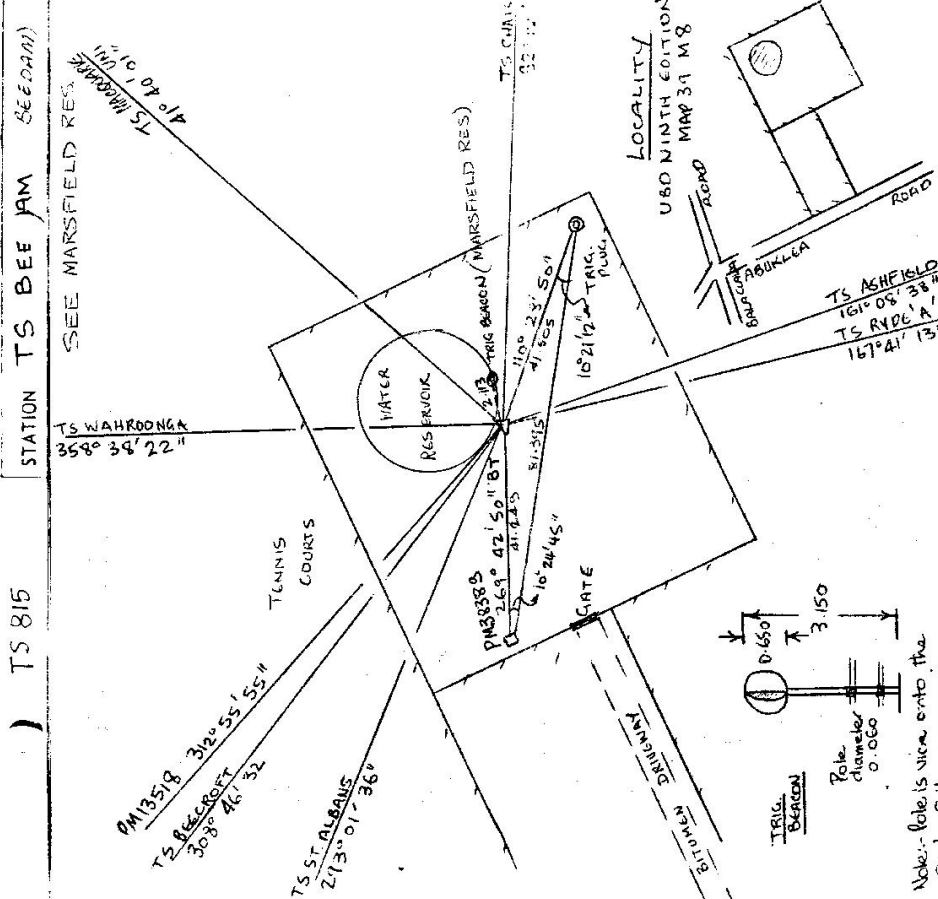

Note:- Pole is vice into the rails of the reservoir.

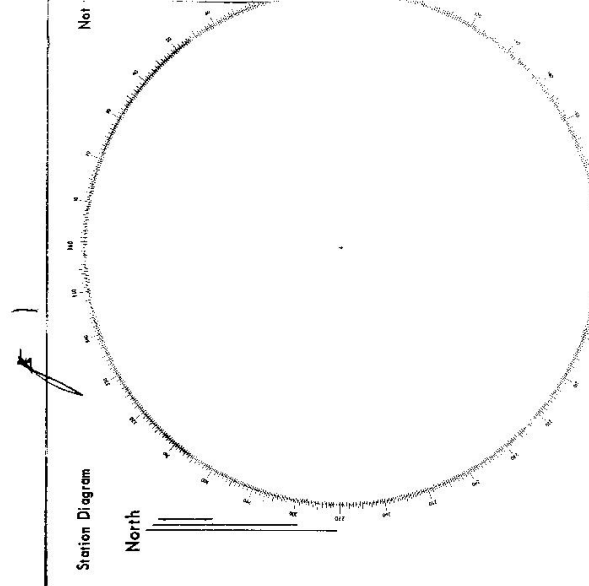

List of Observed Directions:-

Standpoint:	
Station	Direction
Standpoint:	
Station	Direction