Original Beecon has/has not been destroyed by me.	nh.	 1	Heipht Top of Vanes to Top Mark	Description of beacon:	Original beacon found/not found	Original station mark found/not found.	This section to be completed by officer constructing pillar,			61.70	AMENSIONS CATERED	NEW MAST & VAUES		Diameter of Vanes (vertical)		Height of Top Vanes to Top Merk/Pillar plate				Beacon Dizgram Not to Scale	ST 2733-2 D. West, Government Printer, Stationary (1997)
			Date	rager	Phone Fax	k	<u>0</u>	#### Sy		1.95 Rig 2.3 At			829 BELL	Access		Phone: .	*****	Address	Owner's		
			Record of Station	Jer 1800 687 575 INSPECTED BY: С. ГОКЛ DATE: 27-3-01	ē	-1.	Contact Production Officer Illeuro	Sydney Water, Controls this plant and an induction to there safety Procedure may be required, (also you may need a work Permit)	Main office & plant gate, through gate and travel anticlockwise Around the plant to trig	Right into Robert Cram Drive At the entrance of Bellambi Treatment works	Cross bridge over railway line Cross Pioneer road.	Intersection of Northern Distributor and Rothery road Head east towards Bellambi	829 BELLAMBI GS MARCH 2001	Access Report of/19Was found suitable/unsuitable.	ACCESS	Phone: (02) 4284 2967 Phone:		I	Owner's Name: SYDNEY WATER. Current Occupant:	STATION DELLAMBI (P) 829	3


.

×

0N Bellambi [P] 829	L VALUES	INTEGRATED SURVEYS GRID		ZONE C.M.		m(A.H.D); Agency:			and Description of Station. Reference		0 1 1 !	8	2	9					
STATION	PROVISIONAL	AUSTRALIAN MAP GRID	MEI	ZONE CM.	×.	Provisional Heightm(A.H.D		۲ ۲	Date Record of Field Action Marking and D	1 1 1 1 1 1 1 1 1 1 1 1 1 1									•••••••••••••••••••••••••••••••••••••••			4 				
	ACCESS DIAGRAM				ACCESS AS OF 6th June 2016	Contact - Hugo Figgis - Sydney Water	02 4228 2612	02 4252 7604	0403 795 996	hugo.figgis@sydneywater.com.au													•]			-

•

TS829 | Print Date: 31/05/2022 15:11 | No Of Pages: 3 | Property of DFSI – Spatial Services

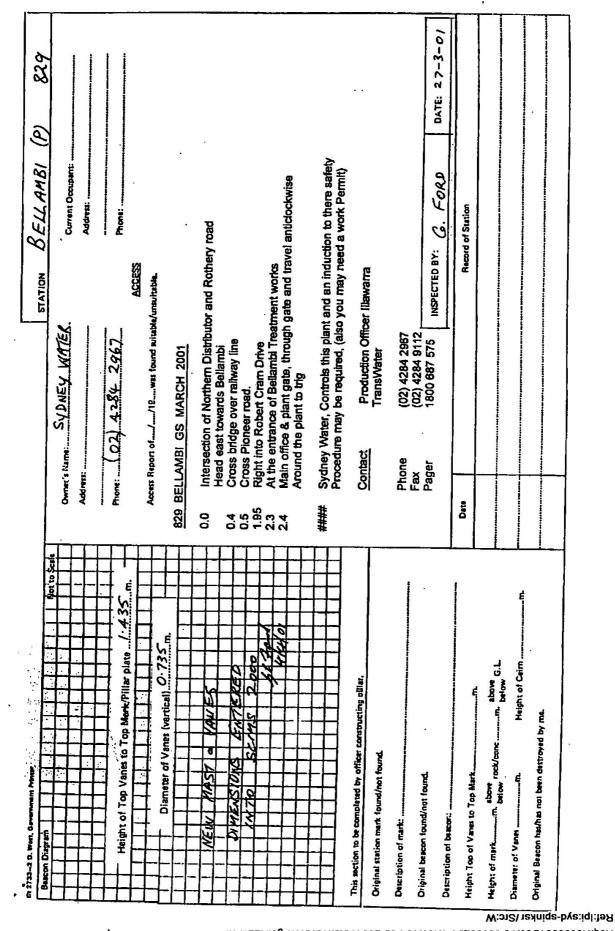

T to T:p92\ST:00 810S-muL-0T:h1\JJA:e99\NO.ON:ef2\A02-d9-0T:v9A\9 eS80000 ST::00\888238A;p9A