

75-103

Department of Lands STATION Bellevue (B) TS 837

Integration Su of N.S.W. Ph: ALEXANDRIA

RECONNAISSANCE and MAINTENANCE REPORT 837 Map Sheet: SYDNEY

No: 1845

Inspected by: L.M HAYES Date: 29-4-76

Authority: Dept of Lands Field Book: GBL104

Beacon Diagram Not to Scale

Note: Cross out word or words which do not apply

This Trig. Station has been:-

1. Completely cleared to permit 360° vision to surrounding Trigs.
2. Cleared by lanes bearing
3. Trig. Mast & Vanes have been painted white & black respectively.
4. The Trig. was unpiled/not unpiled, dimensions now being:

Description of mark: Steel pillar with overhead vane should be explicit, e.g. Steel plug, Brass plug, Bolt, Concrete Pillar

Height of mark: 1.32 m ^{above} ~~below~~ steel platform ^{above} ~~below~~ concrete m ^{above} ~~below~~ G.L.

Height of Top Vanes to ~~Top Mark~~ Top pillar plate: 2.525 m Diameter of Vanes (vertical): 0.60 m.

Height of Cairn: m. Diameter of Cairn: m.

Length of Mast: 1.82 m. (approximate if not unpiled)

5. A set in conc/rock has been placed/fd m. bearing °M from Trig. Mast/pillar
6. A set in conc/soil has been placed/fd m. bearing °M from Trig. Mast/pillar
7. A set in conc/soil has been placed/fd m. bearing °M from Trig. Mast/pillar
8. A set in conc/rock has been placed/fd m. bearing °M from Trig. Mast/pillar
9. Connection to m. bearing °M
10. Connection to m. bearing °M
11. Connection to m. bearing °M
12. Connection to m. bearing °M
13. Diff. Ht. is m. ^{above} ~~below~~
14. Diff. Ht. is m. ^{above} ~~below~~
15. Diff. Ht. is m. ^{above} ~~below~~
16. Diff. Ht. is m. ^{above} ~~below~~

Prepared by: L.M Hayes 29-4-76 Checked: [Signature]

Date Record of Station

STATION Bellevue / T-S. 837


Owners Name..... Current Occupant.....

Address..... Address.....

Access Conventional Vehicle 29-4-1976
 * UBD Map CB H.J, 10
 Access off Rivers St Bellevue Hill

Not to Scale

Station Diagram

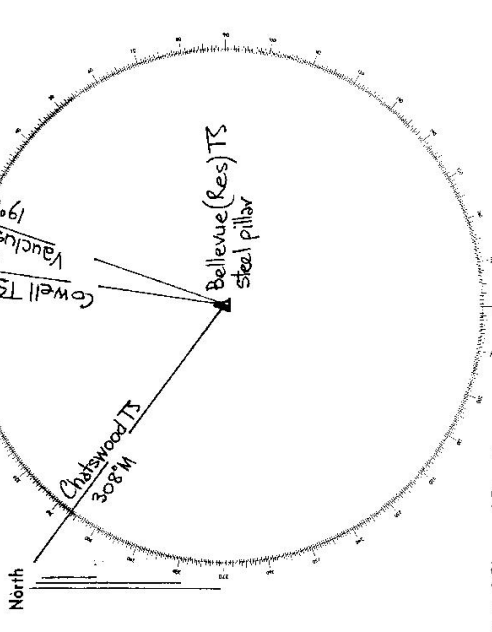

List of Observed Directions:-

Standpoint: steel pillar		Standpoint:	
Station	Direction	Station	Direction
Chatswood TS	308° 59' 68"		
Cowell TS	62° 59' 08"		
Vauchuse TS	72° 05' 47"		
Station	Direction	Station	Direction