

CENTRAL MAPPING AUTHORITY
Department of Lands

Trigonometrical Survey of N.S.W.

RECONNAISSANCE and MAINTENANCE REPORT

This Trig. Station has been:-

Note: Cross out word or words which do not apply

- 1. Completely cleared to permit 360° vision to surrounding Trigs.
- 2. Cleared by limes bearing 325° 32' 35" M. from Trig. Mast
- 3. Trig. Mast & Vanes have been painted white & black respectively.
- 4. The Trig. was unpiled/not unpiled, dimensions now being: Description of mark **BRASS PLUG IN ROCK FOUND**, should be explicit, e.g. Steel plug, Brass plug, Bolt, G.L. Pipe

Height of mark 0.060 m above rock/concrete m above below G.L.
 Height of Top Vanes to Top Mark 4.55 m. Diameter of Vanes (vertical) m.

Height of Cairn m. Diameter of Cairn m.

Length of Mast 1.67 m. (approximate if not unpiled)

- 5. A set in conc/rock has been placed m. bearing °M from Trig. Mast
- 6. A STEEL PIPE set in conc/soil has been placed 3.49 m. bearing 249° M. from Trig. Mast
- 7. A PIPE set in conc/soil has been placed 0.66 m. bearing 110° from Trig. Mast
- 8. A set in conc/rock has been placed m. bearing °M from Trig. Mast

9. Connection to m. bearing °M

10. Connection to m. bearing °M

11. Connection to m. bearing °M

12. Connection to m. bearing °M

13. Diff. Ht. STEEL PIPE PLACED B. is 0.104 m. above below BRASS TRIG PLUG.

14. Diff. Ht. PIPE A. is 6.52 m. above below BRASS Trig Plug.

15. Diff. Ht. is m. above below

16. Diff. Ht. is m. above below

Prepared by: Alan Woodruff 24/2/77. Checked: *MMH* 3.2.77. Noted on U.T.M. Card

STATION **BELOKA TS 843**

Co: Ph:

Map Sheet: **BERRIDALE** No: **8625**

Inspected by: **A. WOODRUFF** Date: **25/1/77**

Authority: **C.M.A** Field Book: **1530**

Beacon Diagram Not to Scale

VANES. WIDTH: 0.225 m
HEIGHT: 0.395 m

MAST 0.08 m sq. 1.67 m

STEEL QUADRANT

2.82 m

BRASS PLUG IN ROCK FOUND

ROCK.

Date Record of Station

Checked

STATION BELOKA T.S. 843

Owners Name.....
 Current Occupant.....
 Address.....
 Address.....


Access 25-1-77
 MILEAGE

DESCRIPTION

FROM Jindabyne Post office Drive towards Threadbo.
 Turn left towards Ingebyra.
 Cross Cobbin Creek.
 Turn left (see sign Jindabyne 6kms).
 Cross narrow Bridge over Mowamba River.
 Join Dirt Road.
 Turn left through gate "Tickalana"
 Pass through gate.



Pass through makeshift gate and follow main track.
 Cross Creek.
 Turn right taking track in Easterly Direction.
 Follow track Southwards and then turn left thru gate.
 Turn right and follow fence southwards.
 Beloka T.S. 50 metres through fence on ridge.

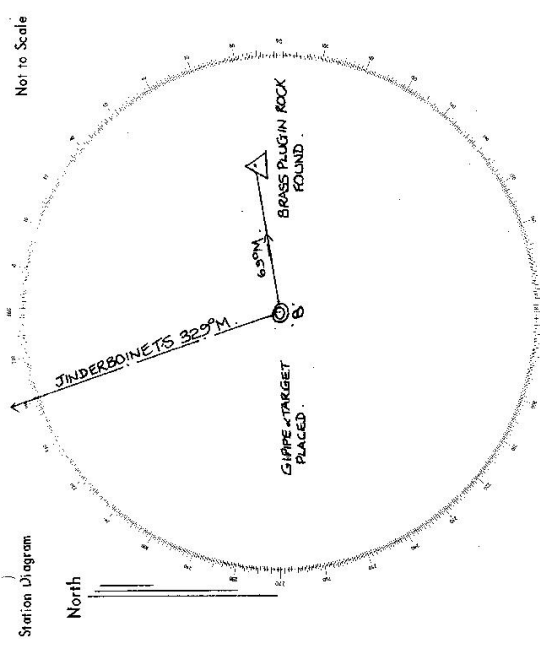

List of Observed Directions:-

Standpoint: G-I Pipe Placed 'B' Standpoint:

Station	Direction	Station	Direction
JINDERBOINE T.S.	0° 00' 00"		
BRASS PLUG IN BELOKA T.S.	106° 20' 12"		

15-6
 16-5
 17-1
 17-4
 17-6
 17-7