

CENTRAL MAPPING AUTHORITY

GEODETIC SURVEY OF N.S.W.

GEODETIC STATION RECONNAISSANCE and MAINTENANCE REPORT

Description:

1. Cleared by lanes bearing..... *See sketch by tall trees*..... from Trig. Mast
Note: Cross out word or words which do not apply
2. Mast & Vanes have been painted white & black respectively.
3. The station/pillar was unpiled/not unpiled/constructed on..... 19....., dimensions now being:
Description of mark..... should be explicit, e.g., S/Steel Pillar Plate, Steel plug, Brass plug, Bolt, G.I. Pipe
Height of mark.....m..... ^{above} rock/concrete; Mark is.....m..... ^{above} G.L.
Height of Top Vanes to Top Mark/Pillar plate.....m..... Diameter of Vanes (vertical).....m.....
Height of Cairn.....m..... Diameter of Cairn.....m..... Name Plate found/not found/placed.
Length of Mast.....m..... (approximate if not unpiled)
4. A..... set in conc/rock has been placed/found, bearing.....° M from Mast/Plug/Pillar
5. A..... set in conc/rock has been placed/found, bearing.....° M from Mast/Plug/Pillar
6. A..... set in conc/rock has been placed/found, bearing.....° M from Mast/Plug/Pillar
7. A..... set in conc/rock has been placed/found, bearing.....° M from Mast/Plug/Pillar
8. Action required:.....

STANDPOINT:

STANDPOINT:

Mark	Direction	Horiz. Distance	Height Difference	Mark	Direction	Horiz. Distance	Height Difference
			above standpt.				above standpt.
			below				below
			above standpt.				above standpt.
			below				below
Prepared by: *W. Miller* / 2-80 Checked:

Noted on U.T.M. Card


Sr: 2733-1

STATION: **BELDON** No.: **844**

MAP SHEET SCALE 1:250 000 **WOLLONGONG**

INSPECTED BY: **W MILLER K HADDOCK** DATE: **25.1.80**

AUTHORITY: **C.M.A.** FIELD BOOK:

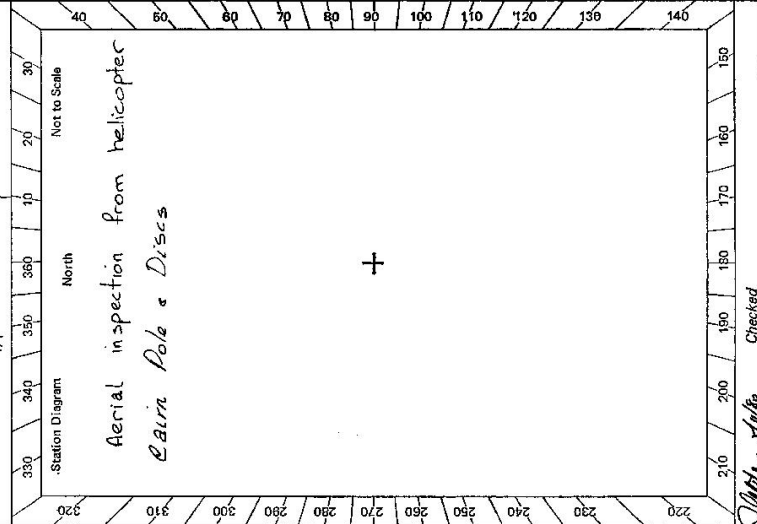

Checked

W. Miller

St 2735-2 D. Veer, Government Printer

Beacon Diagram

Not to Scale



This section to be completed by officer constructing pillar.

Original station mark found/not found.

Description of mark:

Original beacon found/not found.

Description of beacon:

Height Top of Vanes to Top Mark:m.

Height of mark:m. above G.L. below

Diameter of Vanesm.

Original Beacon has/has not been destroyed by me.

STATION **BELOON** * **844**

Owner's Name: **M. W. S. D. S.**
 Address: **Maragambala**
 Phone:
 Current Occupant:
 Address:
 Phone:

ACCESS

Access Report of: **25/1/1980** was found suitable/unsuitable.

SEE **Nattal 1:31680** map

There is a track to the west following the Wollondilly River
 It may be possible to walk from this track and find
 a gap in the cliff

Date: **25/1/80**

Record of Station

Aerial inspection from helicopter