

CENTRAL MAPPING AUTHORITY

GEODETIC SURVEY OF M.S.W.

GEODETIC STATION RECONNAISSANCE and MAINTENANCE REPORT

Description:

1. Cleared by lanes bearing..... S. 54.0° from Trig. Mast
Note: Cross out word or words which do not apply
2. Mast & Vanes have been painted white & black respectively.
3. The station/~~pillar~~ was ~~unplaced~~/not unplaced/~~connected~~ on..... M. 7.7. 19.7.77, dimensions now being:
 Description of mark.....should be explicit, e.g., S/Steel Pillar Plate, Steel plug, Brass plug, Bolt, G.I. Pipe
 Height of mark.....m. above below rock/concrete; Mark is.....m. above below G.L.
 Height of Top Vanes to Top Mark/Pillar platem. Diameter of Vanes (vertical).....0.7.....m.
 Height of Cairn.....1.6.....m. Diameter of Cairn.....1.7.....m. Name Plate found/not found/placed.
 Length of Mastm. (approximate if not unplied)
4. A.....set in conc/rock has been placed/found, bearing.....° M from Mast/Plug/Pillar
5. A.....set in conc/rock has been placed/found, bearing.....° M from Mast/Plug/Pillar
6. A.....set in conc/rock has been placed/found, bearing.....° M from Mast/Plug/Pillar
7. A.....set in conc/rock has been placed/found, bearing.....° M from Mast/Plug/Pillar
8. Action required:.....**STATION SUITABLE FOR CONC. PILLAR.**.....

STANDPOINT:

Mark	Direction	Horiz. Distance	Height Difference	Mark	Direction	Horiz. Distance	Height Difference
			above standpt.				above standpt.
			below				below
			above standpt.				above standpt.
			below				below
Prepared by:

8.8.76 Checked:

Noted on U.T.M. Card

St 2733-1

STATION: **BENEREMBAH** No.: **855**
 MAP SHEET SCALE 1:250 000
 INSPECTED BY: **P. N. M. J.** DATE: **14.7.77**
 AUTHORITY: **C.M.A.** FIELD BOOK:



Station Diagram
 North
 Not to Scale

Checked

STATION **BENEREMBATH 855**

Owner's Name: **W. Tyson**
 Address: **Foen 236C**
 Phone: **Griffith**

Current Occupant: **W. Tyson**
 Address:
 Phone:

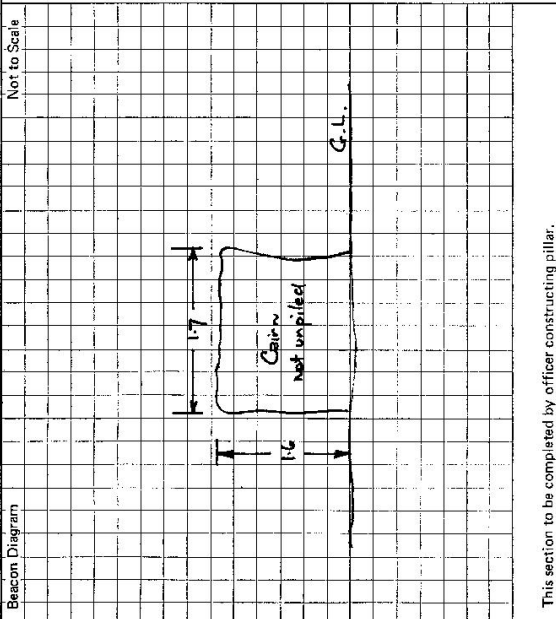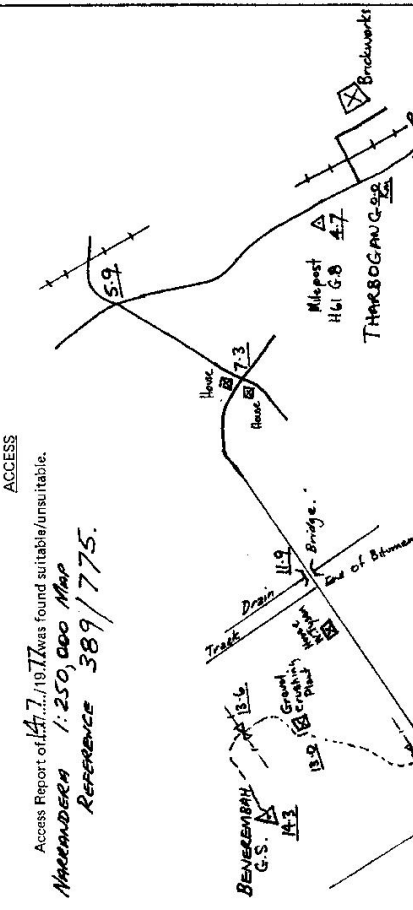

This section to be completed by officer constructing pillar.
 Original station mark found/not found.
 Description of mark:
 Original beacon found/not found.
 Description of beacon:
 Height Top of Vanes to Top Mark m.
 Height of mark m. above below G.L.
 Diameter of Vanes m. Height of Cairn m.
 Original Beacon has/has not been destroyed by me.

Date:
 Record of Station: