

CENTRAL MAPPING AUTHORITY

GEODETTIC SURVEY OF N.S.W.

GEODETTIC STATION RECONNAISSANCE and MAINTENANCE REPORT

Description:

1. Cleared by lanes bearing. *CLEAR LINE TO BANGA GS. 79.54* from Trig. ~~MARK~~

2. Mast & Vanes have been painted white & black respectively.

3. The station/~~mark~~ was unpilled/~~replaced~~ on *14 December 1984*, dimensions now being:

Description of mark/~~mark~~ should be explicit, e.g., S/Steel Pillar Pipe, Steel plug, Brass plug, Bolt, G.I. Pipe

Height of mark *2.050* m. above ~~mark~~ below ~~mark~~ Mark is *CONCRETE* above G.L.

Height of Top Vanes to Top Mark *3.655* m. Diameter of Vanes (vertical) *1.015* m.

Height of Cairn *1.000* m. Diameter of Cairn *2.000* m. Name Plate found/not ~~found~~/placed.

Length of Mast *3.705* m. (approximate if not unpilled)

4. *S.S.M.* set in conc/~~rock~~ has been ~~replaced~~/found, bearing *330*°M from ~~mark~~/Plug/~~mark~~

5. *Gal. Pipe* set in conc/~~rock~~ has been ~~replaced~~/found, bearing *284*°M from ~~mark~~/Plug/~~mark~~

6. *A.* set in conc/rock has been placed/found, bearing *.....*°M from Mast/Plug/Pillar

7. *A.* set in conc/rock has been placed/found, bearing *.....*°M from Mast/Plug/Pillar

8. Action required: *PAVE CONCRETE PAVING*

STANDPOINT:

| Mark | Direction | Horiz. Distance | Height Difference | Mark | Direction | Horiz. Distance | Height Difference |
|------|-----------|-----------------|-------------------|------|-----------|-----------------|-------------------|
| | | | above standpt. | | | | below standpt. |
| | | | below | | | | above standpt. |
| | | | above standpt. | | | | below standpt. |
| | | | below | | | | above standpt. |
Prepared by: *P. BETTS* 12.12.84 Checked: *AS* 10.1.85 Noted on U.T.M. Card *144*

WA 107

STATION: *BERMAGUI GS.* No.: *876*
 MAP SHEETS *BEBA* SCALE 1:250 000
 INSPECTED BY: *P. BETTS* DATE: *11/2/84*
 AUTHORITY: *C.M.A.* FIELD BOOK: *1947*


Station Diagram

Checked *144* 12/85

SI 2723-2 O. West, Government Printer

STATION BERNHAGUI G.S. 876

Owner's Name:
 Address:
 Phone:
 Current Occupant:
 Address:
 Phone:

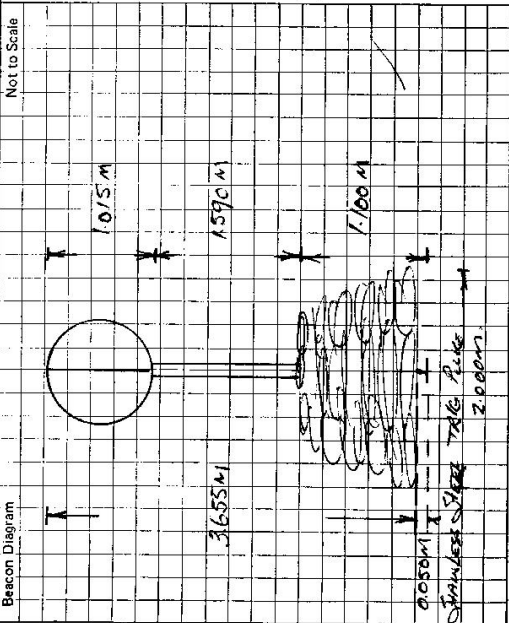

ACCESS

Access Report of 11/12/1988 was found suitable/unsuitable.

FEATURE

0.01 ROAD OFFICE BERNHAGUI NEAR SOUTH

0.10 TURN LEFT INTO CAROLINA STREET

0.31 TURN RIGHT INTO MONTAGUE STREET

0.39 TURN LEFT INTO PACIFIC STREET

0.50 CROSS OCEANIC DRIVE INTO BLUE RIV RESERVE

0.59 BERNHAGUI G.S.

This section to be completed by officer constructing pillar.

Original station mark found/not found.

Description of mark:

Original beacon found/not found.

Description of beacon:

Height Top of Vanes to Top Mark.....m.

Height of mark.....m. above rock/conc.....m. below G.L.

Diameter of Vanes.....m. Height of Cairn.....m.

Original Beacon has/has not been destroyed by me.

| Date | Record of Station |
|------|-------------------|
| | |
| | |
| | |
| | |

CENTRAL MAPPING AUTHORITY

GEODETTIC SURVEY OF N.S.W.

GEODETTIC STATION RECONNAISSANCE and MAINTENANCE REPORT

Description:

1. Cleared by lanes bearing..... Note: Cross out word or words which do not apply from Trig. Mast
2. Mast & Vanes have been painted white & black respectively.
3. The station/pillar was unpiled/not unpiled/constructed on..... 19..... dimensions now being:

Description of mark..... should be explicit, e.g., S/Steel Pillar Plate, S/Steel Plug, Brass plug, Bolt, G.I. Pipe

Height of mark.....m. above below rock/concrete; Mark is $\frac{11}{11}$ m. above G.L.

Height of Top Vanes to Top Mark/Pillar plate.....m. Diameter of Vanes (vertical).....m.

Height of Cairn.....m. Diameter of.....m. Name Plate found/not found/placed.

Length of Mast.....m. (approximate if not unpiled)

4. A..... set in conc/rock has been placed/found, bearing.....°M from Mast/Plug/Pillar

5. A..... set in conc/rock has been placed/found, bearing.....°M from Mast/Plug/Pillar

6. A..... set in conc/rock has been placed/found, bearing.....°M from Mast/Plug/Pillar

7. A..... set in conc/rock has been placed/found, bearing.....°M from Mast/Plug/Pillar

8. Action required:.....

STANDPOINT: STAINLESS STEEL TRIG PLUG ✓ STATION: SSM IN CONC ✓


| Mark | Direction | Horiz. Distance | Height Difference | Mark | Direction | Horiz. Distance | Height Difference |
|-------------------|-----------|-----------------|-------------------|-------------------|------------|-----------------|-------------------|
| BUNGA G.S. | 0 00 00 | ✓ | above standpt | BUNGA G.S. | 0 00 00 | ✓ | above standpt |
| MUMULLA G.S. | AL 51 062 | ✓ | above standpt | BERAGUI G.I. Pipe | 34 36 ✓ | 2.857 | above standpt |
| BERAGUI G.I. Pipe | 108 34 03 | ✓ 3.830 | below | BERAGUI 200C L.H. | 125 41 052 | ✓ | above standpt |
| BERAGUI SSM | 150 38 30 | ✓ 4.099 | below | BERAGUI Trig Plug | 380 40 00 | ✓ 4.099 | above standpt |
| | | | below | | | | below |
| | | | above standpt | | | | below |
| | | | below | | | | above standpt |
| | | | above standpt | | | | below |

Prepared by: G. Dickson 22-3-85

Checked: 22/3/85

Checked

Noted on U.T.M. Card

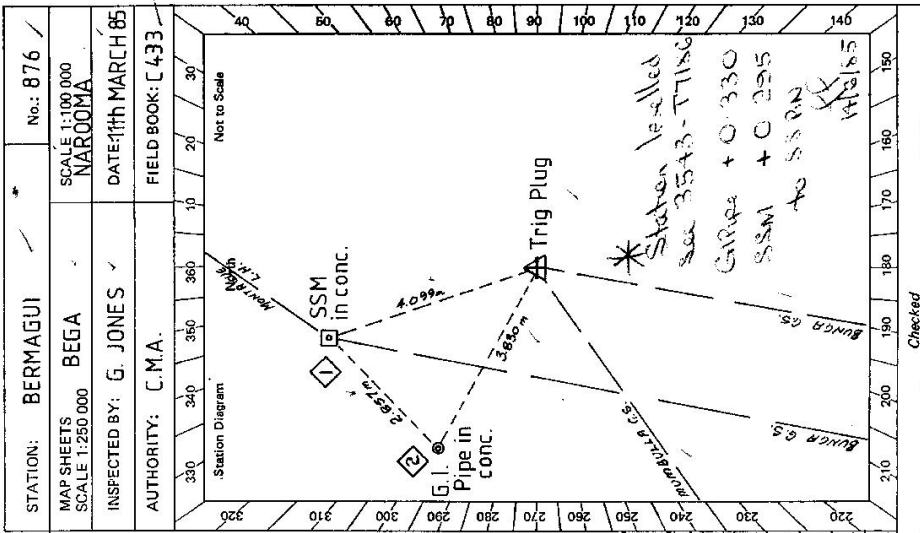


STATION: BERAGUI No.: 876

MAP SHEETS SCALE 1:100 000 BEGA NAROOMA

INSPECTED BY: G. JONES DATE: 11th MARCH 85

AUTHORITY: C.M.A. FIELD BOOK: C 433

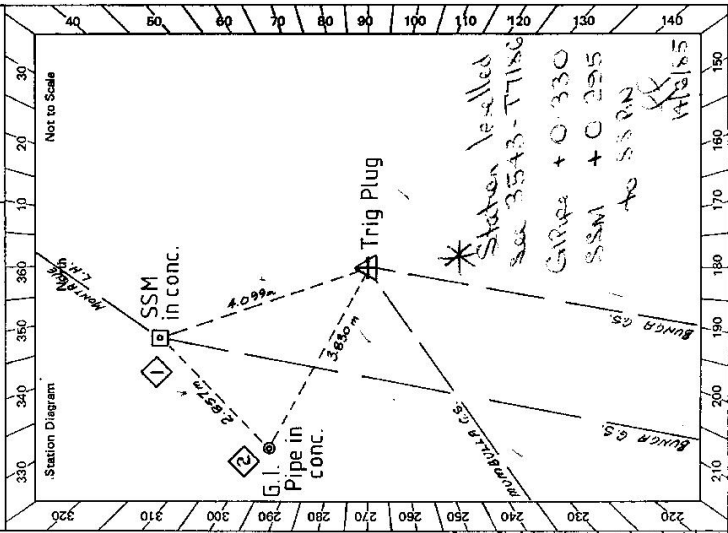

EP 2750-2 D. West, Government Printer

STATION **BERMAGUI** * **876**

| | |
|----------------|--------------|
| Beacon Diagram | Not to Scale |
| | |

Owner's Name:
 Address:
 Phone:

Current Occupant:
 Address:
 Phone:

ACCESS

Access Report of 11.1.12 / 1984 was found suitable/unsuitable.

This section to be completed by officer constructing pillar.

Original station mark found/not found.

Description of mark:

Original beacon found/not found.

Description of beacon:

Height Top of Vanes to Top Markm.

Height of markm. above / below rock/concm. above / below G.L.

Diameter of Vanesm. Height of Cairnm.

Original Beacon has/has not been destroyed by ms.

Date

Record of Station