

CENTRAL MAPPING AUTHORITY

GEODETIC SURVEY OF NSW

GEODETIC STATION RECONNAISSANCE and MAINTENANCE REPORT


STATION: *BEROWRA G.S.* No.: *877*

MAP SHEET SCALE 1:250 000 *SYDNEY*

INSPECTED BY: *T. Moreston* DATE: *24.7.75*

AUTHORITY: *C.M.A.* FIELD BOOK:

- Description:
1. Cleared by lanes bearing..... *Note: Cross out word or words which do not apply*..... from Trig. Mast
  2. Mast & Vanes have been painted white & black respectively.
  3. The station/pillar was unpiled/not unpiled/constructed on.....19....., dimensions now being: Description of mark.....should be explicit, e.g., S/Steel Pillar Plate, Steel plug, Brass plug, Bolt, G.I. Pipe  
Height of mark.....m. <sup>above</sup> rock/concrete; Mark is.....m. <sup>above</sup> G.L.  
Height of Top Vanes to Top Mark/Pillar plate.....m. Diameter of Vanes (vertical).....m.  
Height of Cairn.....m. Diameter of Cairn.....m. Name Plate found/not found/placed.  
Length of Mast.....m. (approximate if not unpiled)
  4. A.....set in conc/rock has been placed/found, bearing.....° M from Mast/Plug/Pillar
  5. A.....set in conc/rock has been placed/found, bearing.....° M from Mast/Plug/Pillar
  6. A.....set in conc/rock has been placed/found, bearing.....° M from Mast/Plug/Pillar
  7. A.....set in conc/rock has been placed/found, bearing.....° M from Mast/Plug/Pillar
  8. Action required:.....

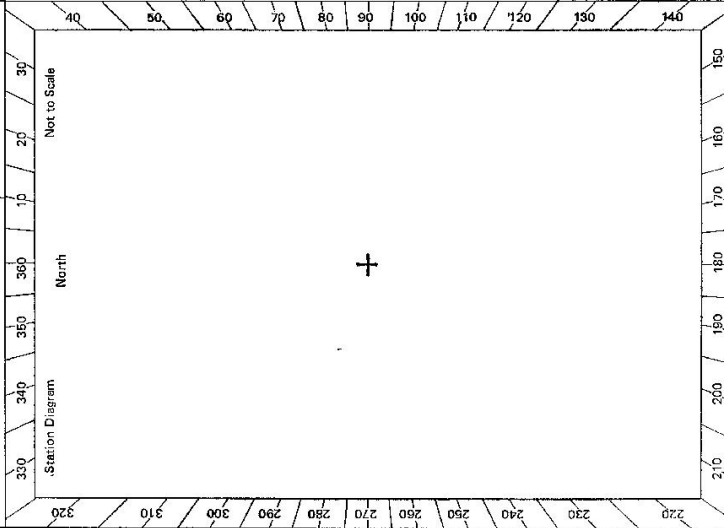

STANDPOINT:

Mark	Direction	Horiz. Distance	Height Difference	Mark	Direction	Horiz. Distance	Height Difference
			above standpt.				above standpt.
			below				below
			above standpt.				above standpt.
			below				below
Prepared by: *M.L. Moreston* Checked: *[Signature]* Noted on U.T.M. Card



CENTRAL MAPPING AUTHORITY

GEODETIC SURVEY OF N.S.W.

GEODETIC STATION RECONNAISSANCE and MAINTENANCE REPORT

STATION: BEROWRA No.: 877

MAP SHEET SCALE 1:250 000 SYDNEY

INSPECTED BY: DATE: 6.4.76

AUTHORITY: C.M.A. FIELD BOOK: 1490:12

- Description:**
1. Cleared by lanes bearing..... *Note: Cross out word or words which do not apply*
  2. Mast & Vanes have been painted white & black respectively.
  3. The station/pillar was unpiled/not unpiled/constructed on..... 19....., dimensions now being:  
Description of mark.....should be explicit, e.g., S/Steel Pillar Plate, Steel plug, Brass plug, Bolt, G.I. Pipe  
Height of mark.....m. above rock/concrete; Mark is.....m. above G.L.  
Height of Top Vanes to Top Mark/Pillar plate .....m. Diameter of Vanes (vertical).....m.  
Height of Cairn.....m. Diameter of Cairn.....m. Name Plate found/not found/placed.  
Length of Mast .....m. (approximate if not unpiled)
  4. A.....set in conc/rock has been placed/found, bearing.....° M from Mast/Plug/Pillar
  5. A.....set in conc/rock has been placed/found, bearing.....° M from Mast/Plug/Pillar
  6. A.....set in conc/rock has been placed/found, bearing.....° M from Mast/Plug/Pillar
  7. A.....set in conc/rock has been placed/found, bearing.....° M from Mast/Plug/Pillar
  8. Action required:.....


STANDPOINT:

Mark	Direction	Horiz. Distance	Height Difference	Mark	Direction	Horiz. Distance	Height Difference
			above standpt.				above standpt.
			below standpt.				below standpt.
			above standpt.				above standpt.
			below standpt.				below standpt.
			above standpt.				above standpt.
			below standpt.				below standpt.
			above standpt.				above standpt.
			below standpt.				below standpt.

Prepared by:


Checked: *Noted on U.T.M. Card*

Sr 2733-1

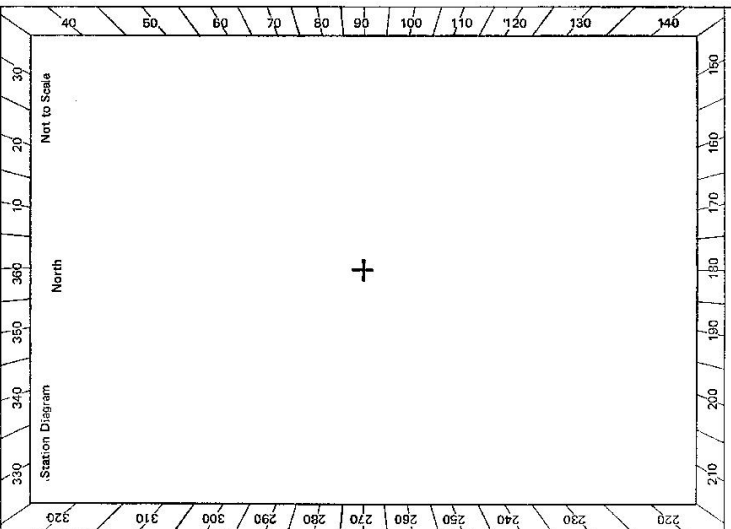

BEROWRA

Boyle Book 1490  
 Folio 12

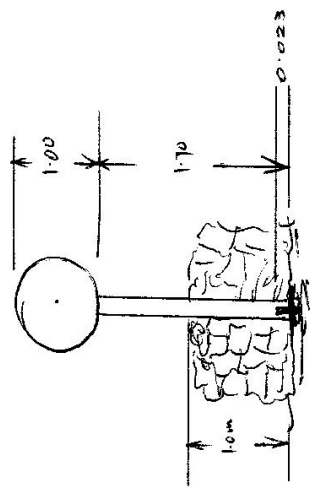

Plug is 0.023m above rock  
 Effective Ht of Mast 2.677

Date 6.4.76  
 J. R. Wilson  
 8/12/78

STATION **BEROWRA 877**

Owner's Name: .....  
 Address: .....  
 Phone: .....  
 Current Occupant: .....  
 Address: .....  
 Phone: .....

ACCESS  
 Access Report of 6.4.76 was found suitable/unsuitable.

Date	Record of Station