

878  
 STATION BEROWRA RES TS 878  
 Department of Lands  
 Integral Survey of N.S.W.  
 RECONNAISSANCE and MAINTENANCE REPORT

STATION BEROWRA RES TS 878  
 STATION BEROWRA RES TS 878  
 Co: \_\_\_\_\_ Ph: \_\_\_\_\_  
 Map Sheet: \_\_\_\_\_ No: \_\_\_\_\_  
 Inspected by: \_\_\_\_\_ Date: \_\_\_\_\_  
 Authority: \_\_\_\_\_ Field Book: \_\_\_\_\_  
 Beacon Diagram \_\_\_\_\_ Not to Scale

Note: Cross out word or words which do not apply

- This Trig. Station has been:
1. Completely cleared to permit 360° vision to surrounding Trigs.
  2. Cleared by lanes bearing..... from Trig. Mast

STATION BEROWRA  
 To \_\_\_\_\_  
 Remarks  
 Levelling from P.M. 204, prov. value = 705.054 FT (215.205 m)  
 Adjusted value of P.M. 254 = 215.165 m. D.M. = 9.040 m  
 215.165 A.M.O. (SURVEY) 18-3-1975  
 A.H.D.  
~~520.820~~  
 FT METRES  
 524.820 217.080  
 822.820 250.820  
 820.820 252.215  
 Conc. Platform 26  
 214.820 218.215  
 LANDS  
 L.F. 17390, 17472.  
 03 TR

G.30  
 TZ: Connection: 10..... m. bearing: .....  
 13. Diff. Hr. .... is ..... m. above  
 Below  
 14. Diff. Hr. .... is ..... m. above  
 Below  
 15. Diff. Hr. .... is ..... m. above  
 Below  
 16. Diff. Hr. .... is ..... m. above  
 Below  
 Prepared by: \_\_\_\_\_  
 Checked: \_\_\_\_\_  
 Date \_\_\_\_\_ Record of Station \_\_\_\_\_

STATION TS 878 Berowira, Res


Owners Name

Current Occupant

Address

Address

Station Diagram Not to Scale

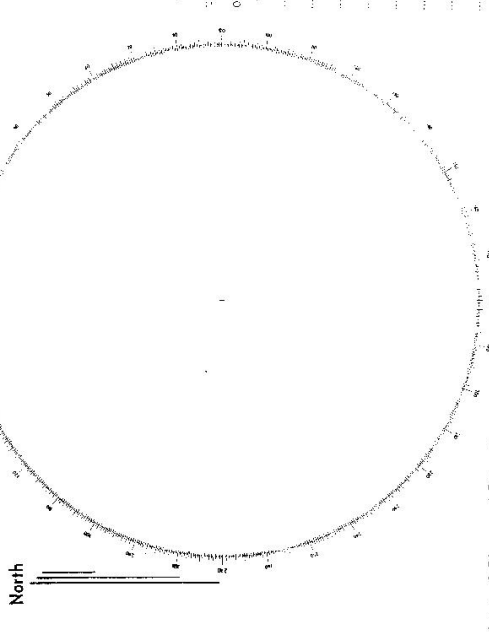

List of Observed Directions:-

Standpoint:		
Station	Direction	Direct
Standpoint:		
Station	Direction	Direct

Remarks

BEROWIRA TS  
BOUNDARY RD  
BRASS NAIL IN CONcrete  
TIP OF SIDE OF TANK

