

CENTRAL MAPPING AUTHORITY


GEODETIC SURVEY OF N.S.W.
 GEODETIC STATION RECONNAISSANCE and MAINTENANCE REPORT

STATION: **BIBBIJOLEE 63** No.: **899**

MAP SHEET SCALE 1:250 000
 Cargelligo 1:250 000
 Ungarie 1:50 000

INSPECTED BY: **Ian W. Robins** DATE: **10/11/78**

AUTHORITY: **C.M.A.** FIELD BOOK:

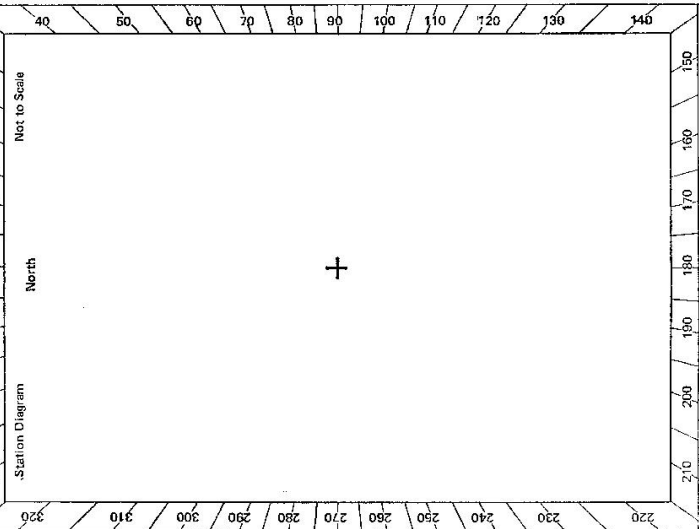

- Description:
1. ~~Cleared by James Beattie~~ Note: Cross out word or words which do not apply
 from Trig. Mast
 2. Mast & Vanes have been painted white & black respectively.
 3. The station/~~pillar~~ was ~~unplaced~~/not unplaced/~~constructed on~~ dimensions now being
 Description of mark..... should be explicit, e.g., S/Steel Pillar Plate, Steel plug, Brass plug, Bolt, G.I. Pipe
 Height of mark..... m. above below rock/concrete; Mark is m. above below G.L.
 - Height of Top Vanes to Top Mark/Pillar plate m. Diameter of Vanes (vertical)..... m.
 - Height of Cairn..... m. Diameter of Cairn..... m. Name Plate found/not found/placed.
 - Length of Mast..... m. (approximate if not unplaced)
 4. A..... set in conc/rock has been placed/found, bearing.....° M from Mast/Plug/Pillar
 5. A..... set in conc/rock has been placed/found, bearing.....° M from Mast/Plug/Pillar
 6. A..... set in conc/rock has been placed/found, bearing.....° M from Mast/Plug/Pillar
 7. A..... set in conc/rock has been placed/found, bearing.....° M from Mast/Plug/Pillar
 8. Action required: *Trig. is silly enough. Mast by timber up to 10m high. 300 view of clear. not by lorry mast should be replaced; no standards to be found.*

Mark	Direction	Horiz. Distance	Height Difference	Mark	Direction	Horiz. Distance	Height Difference
			above standpt.				above standpt.
			below standpt.				below standpt.
			above standpt.				above standpt.
			below standpt.				below standpt.
Prepared by: **Ian W. Robins 75/11/78** Checked: **Checked**
 Noted on U.T.M. Card

St 2735-2 D. West, Government Printer Beacon Diagram Not to Scale		Owner's Name: <i>Mr. Ray G. Thomas</i> Address: <i>"Trigalo" via Ungarie RN 2669</i> Phone: <i>Ungarie 183 or Ungarie 183 business ACCESS 10-11-78</i> Current Occupant: <i>As per former</i> Address: Phone: Access Report of/10 was found suitable for measurement.
This section to be completed by officer constructing pillar. Original station mark found/not found. Description of mark: Original beacon found/not found. Description of beacon: Height Top of Vanes to Top Mark m. Height of mark m. above G.L. below Diameter of Vanes m. Height of Cairn m. Original Beacon has/has not been destroyed by me.		STATION BIBBIOLEE G.S. 899 Owner's Name: <i>Mr. Ray G. Thomas</i> Address: <i>"Trigalo" via Ungarie RN 2669</i> Phone: <i>Ungarie 183 or Ungarie 183 business ACCESS 10-11-78</i> Current Occupant: <i>As per former</i> Address: Phone: Access Report of/10 was found suitable for measurement.
1. from Ungarie P.O. take West along road. After abt 1km take Mendenhall road to right across railway. Follow past two sharp bends to the access track to "Trigalo"		Date Record of Station
		Date Record of Station