

CENTRAL MAPPING AUTHORITY

GEODETIC SURVEY OF N.S.W.

GEODETIC STATION RECONNAISSANCE and MAINTENANCE REPORT

Description: *Note: Cross out word or words which do not apply*

1. Cleared by lanes bearing..... from Trig. Mast
2. Mast & Vanes have been painted white & black respectively.
3. The station/pillar was unpiled/not unpiled/constructed on.....19....., dimensions now being:
 Description of mark.....should be explicit, e.g., S/Steel Pillar Plate, Steel plug, Brass plug, Bolt, G.I. Pipe
 Height of mark.....m. ^{above} rock/concrete; Mark is.....m. ^{above} G.L. _{below}
 Height of Top Vanes to Top Mark/Pillar plate.....m. Diameter of Vanes (vertical).....m.
 Height of Cairn.....m. Diameter of Cairn.....m. Name Plate found/not found/placed.
 Length of Mast.....m. (approximate if not unpiled)
4. A.....set in conc/rock has been placed/found, bearing.....° M from Mast/Plug/Pillar
5. A.....set in conc/rock has been placed/found, bearing.....° M from Mast/Plug/Pillar
6. A.....set in conc/rock has been placed/found, bearing.....° M from Mast/Plug/Pillar
7. A.....set in conc/rock has been placed/found, bearing.....° M from Mast/Plug/Pillar
8. Action required.....*No action.*

| STANDPOINT: | | STANDPOINT: | | STANDPOINT: | | STANDPOINT: | |
|-------------|-----------|-----------------|-------------------|-------------|-----------|-----------------|-------------------|
| Mark | Direction | Horiz. Distance | Height Difference | Mark | Direction | Horiz. Distance | Height Difference |
| | | | above standpt | | | | above standpt |
| | | | below | | | | below |
| | | | above standpt | | | | above standpt |
| | | | below | | | | below |
Prepared by: *927* 8/7/81 Checked: *8/7/81* 21.7.81 *Noted on U.T.M. Card*

87 2733-1


STATION: *BICKAN TS.* No.: *902*
 MAP SHEET SCALE 1:250 000
 INSPECTED BY: *G. JONES* DATE: *23.6.81*
 AUTHORITY: *CMA* FIELD BOOK: *1915*

Station Diagram

Not to Scale

SI 2733-2 D. West, Government Printer

STATION **BICKAN** * **902**

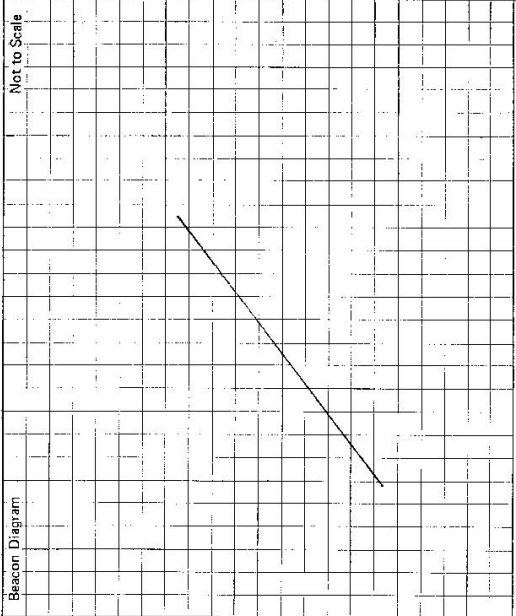

Owner's Name: **GOONOO STATE FOREST FORESTRY COMMISSION**
 Address: **264 MACCALLUM ST**
 Phone: **DUARRO**
 Current Occupant:
 Address:
 Phone:
 ACCESS **23-6-81**

Access Report of: **1975** was found ~~inadequate~~/unsuitable.

- 0.0 Railway crossing in DUARRO on Newell Hwy towards Gilgandra
- 0.15 Turn right. sign. "Gilgandra."
- 0.35 Turn left. sign. "Gilgandra."
- 7.5 AT BROCKLEHURST. Turn right. sign "Magrigny (Mendoboran 68."
- 7.85 Follow sealed road to the left.
- 10.8 Straight ahead. sign. "Magrigny."
- 21.3 Turn right along sealed road. (towards side)
- 21.8 Railway crossing
- 25.2 Pass roads to right and left. Sealed road ends.
- 26.75 Sign. "Goonoo State forest."
- 26.85 Veer right, off main road.
- 29.2 Take right fork.
- 30.0 Pass Tracks on right.
- 30.55 Turn right onto faint track.
- 30.7 Take right fork.
- 31.8 Δ

AND all weather access.

This section to be completed by officer constructing pillar.

Original station mark found/not found.

Description of mark: ~~.....~~

Original beacon found/not found.

Description of beacon: ~~.....~~

Height Top of Vanes to Top Mark: ~~.....m.~~

Height of mark: ~~.....m. above G.L. below~~

Diameter of Vanes: ~~.....m.~~

Original Beacon has/has not been destroyed by me.

| Date | Record of Station |
|------|-------------------|
| | |
| | |
