

GEODETTIC SURVEY OF A.S.M

CENTRAL MAPPING AUTHORITY

GEODETTIC STATION RECONNAISSANCE and MAINTENANCE REPORT


- Description:
1. Cleared by lanes bearing.....  
*Note: Cross out word or words which do not apply*
2. ~~Mast & Vanes have been painted white & black respectively.~~
3. The station/pillar was unpiled/not unpiled/constructed on.....19....., dimensions now being:  
 Description of mark.....should be explicit, e.g., S/Steel Pillar Plate, Steel plug, Brass plug, Bolt, G.I. Pipe  
 Height of mark.....<sup>above</sup> rock/concrete; Mark is.....<sup>above</sup>.....<sup>below</sup> G.L.  
 Height of Top Vanes to Top Mark/Pillar plate .....m. Diameter of Vanes (vertical).....m.  
 Height of Cairn.....m. Diameter of Cairn.....m. Name Plate found/not found/placed,  
 Length of Mast .....m. (approximate if not unpiled)
4. A.....set in conc/rock has been placed/found, bearing.....°M from Mast/Plug/Pillar
5. A.....set in conc/rock has been placed/found, bearing.....°M from Mast/Plug/Pillar
6. A.....set in conc/rock has been placed/found, bearing.....°M from Mast/Plug/Pillar
7. A.....set in conc/rock has been placed/found, bearing.....°M from Mast/Plug/Pillar
8. Action required: Needs painting black and white

STATION: **B 166AM NORTH** No.: **9 / 0**

MAP SHEET SCALE 1:250 000 **B 66A**

INSPECTED BY: **G. KEEP** DATE: **22 / 5 / 80**

AUTHORITY: FIELD BOOK:

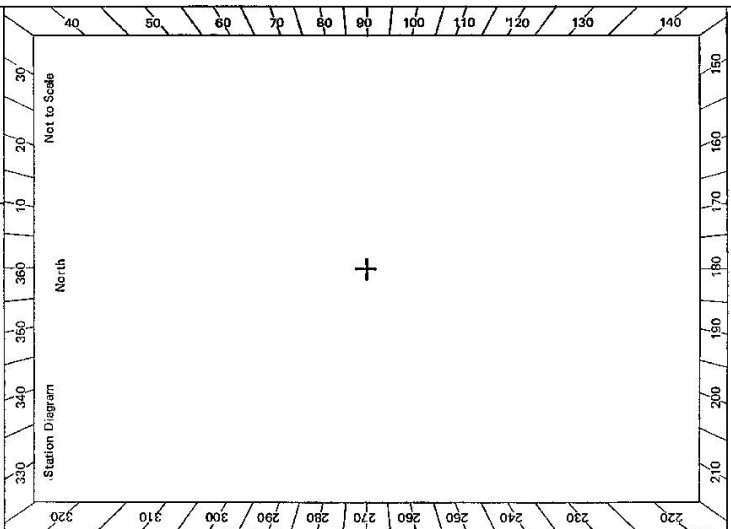

STANDPOINT:				STANDPOINT:			
Mark	Direction	Horiz. Distance	Height Difference	Mark	Direction	Horiz. Distance	Height Difference
			above standpt.				above standpt.
			below standpt.				below standpt.
			above standpt.				above standpt.
			below standpt.				below standpt.
Prepared by: **G. Keep 22/5/80** Checked: **Noted on U.T.M. Card**

