

CENTRAL MAPPING AUTHORITY

GEODETIC SURVEY OF N.S.W.

GEODETIC STATION RECONNAISSANCE and MAINTENANCE REPORT

Description:

- Note: Cross out word or words which do not apply
- Cleared by lances bearing **Thick, medium timber 360°** ..... from Trig. Mast
  - ~~Mast & Vanes have been painted white & black respectively.~~
  - The station/pillar was ~~unpiled/constructed~~ on ..... 19....., dimensions now being:  
Description of mark..... should be explicit, e.g., S/Steel Pillar Plate, Steel plug, Brass plug, Bolt, G.I. Pipe  
Height of mark.....m. <sup>above</sup> rock/concrete; Mark is.....m. <sup>above</sup> G.L.
  - Height of Top Vanes to Top Mark/Pillar plate .....m. Diameter of Vanes (vertical).....**0.94**m.  
**on Ground**
  - Height of Cairn.....**1.0**m. Diameter of Cairn.....**2.0**m. Name Plate found/not found/~~placed~~.
  - Length of Mast.....m. (approximate if not unpiled)
  - A.....set in conc/rock has been placed/found, bearing.....° M from Mast/Plug/Pillar
  - A.....set in conc/rock has been placed/found, bearing.....° M from Mast/Plug/Pillar
  - A.....set in conc/rock has been placed/found, bearing.....° M from Mast/Plug/Pillar
  - A.....set in conc/rock has been placed/found, bearing.....° M from Mast/Plug/Pillar

Action required:..... **CHATSBURY**.....  
STANDPOINT: **1:25,000**

Mark	Direction	Horiz. Distance	Height Difference	Mark	Direction	Horiz. Distance	Height Difference
			above standpt.				above standpt.
			below				below
			above standpt.				above standpt.
			below				below
Prepared by: *[Signature]* Checked: *[Signature]* Noted on U.T.M. Card

St 2738-1

STATION: **BIG HILL** No.: **S/2**

MAP SHEET SCALE 1:250 000 **Goulburn**

INSPECTED BY: **A Sivertsen** DATE: **7-11-78**


AUTHORITY: **CMA** FIELD BOOK: **1717**

Station Diagram

3-5 days clearing - easily lanced  
 ↳ owners brother at "Hillview" property to north reckons no objection to clearing  
 Beech in poor condition  
 Fair Δ when cleared.

St 2735-2 D. West. Government Printer

Beacon Diagram

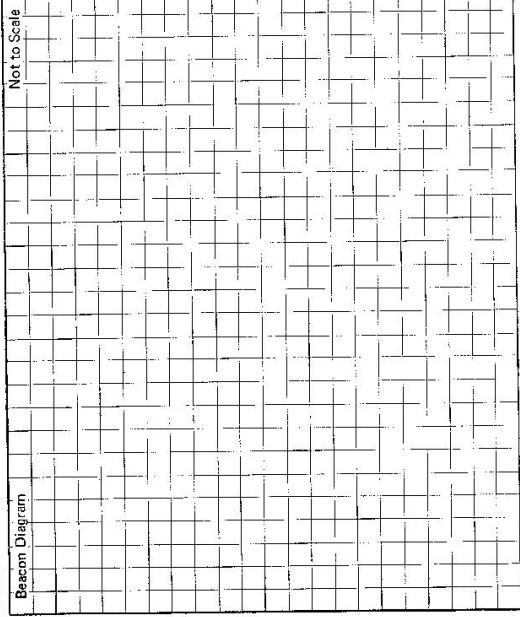

Owner's Name: **Austin PHILLIPS**  
 Address: **Garret St**  
**MOSS VALE**  
 Phone: .....

Current Occupant: .....

**ACCESS**

Access Report of 7.11.19 was found suitable/unsuitable.

From **MARULAN** take **BIG HILL / BRAYTON** road for 18 km  
 0-0 At sign **BIG HILL** Take this road  
**GREENWICH PARK 5**  
**GOULBURN 31**  
**MARULAN 18**  
 2-7 Take **JEFFREYS ROAD** to L  
 3-5 Through iron gate on R  
 4-2 After wet gully turn R up spur  
 5-4 Cross fence near corner  
 5-5 **△ BIG HILL**

STATION **BIG HILL 912**

This section to be completed by officer constructing pillar.

Original station mark found/not found.  
 Description of mark: .....  
 Original beacon found/not found.  
 Description of beacon: .....  
 Height Top of Vanes to Top Mark: .....m.  
 above below  
 Height of mark: .....m. rock/conc .....m. above G.L. below  
 Diameter of Vanes .....m. Height of Cairn .....m.  
 Original Beacon has/has not been destroyed by me.

Date	Record of Station

CENTRAL MAPPING AUTHORITY

GEODETIC SURVEY OF N.S.W.

GEODETIC STATION RECONNAISSANCE and MAINTENANCE REPORT

Description:

1. Cleared by lanes bearing Timberless 300° North cross out word or words which do not apply from Trig. Mast

2. Mast & Vanes have been painted white & black respectively. X

3. The station/~~marker~~ was ~~unplaced~~/not unplaced/~~constructed~~ on 9.7 19.84, dimensions now being:

Description of mark, Rock Cairn, should be explicit, e.g., S/Steel Pillar Plate, Steel plug, Brass plug, Bolt, G.I. Pipe

Height of mark 0.4 m. <sup>above</sup>/<sub>below</sub> rock/concrete; Mark is 0.3 m. <sup>above</sup>/<sub>below</sub> G.L.

Height of Top Vanes to Top Mark/Pillar plate 0.3 m. Diameter of Vanes (vertical) 0.3 m. <sup>on</sup>/<sub>ground</sub>

Height of Cairn 1.4 m. Diameter of Cairn 1.4 m. Name Plate ~~found~~/not found/~~placed~~.

Length of Mast 0.9 m. (approximate if not unplaced)

4. A. 0.9 set in conc/rock has been placed/found, bearing 198.4 °M from Mast/Plug/Pillar

5. A. 0.9 set in conc/rock has been placed/found, bearing 198.4 °M from Mast/Plug/Pillar

6. A. 0.9 set in conc/rock has been placed/found, bearing 198.4 °M from Mast/Plug/Pillar

7. A. 0.9 set in conc/rock has been placed/found, bearing 198.4 °M from Mast/Plug/Pillar

8. Action required: .....

STANDPOINT:

STANDPOINT:

Mark	Direction	Horiz. Distance	Height Difference	Mark	Direction	Horiz. Distance	Height Difference
			above standpt				above standpt
			below				below
			above standpt				above standpt
			below				below
Prepared by: D. J. KAIN Checked: D.

Noted on U.T.M. Card

STATION: Big Hill Geodetic Station No.: 912  
 MAP SHEETS SCALE 1:250 000 Goulburn SCALE 1:100 000  
 INSPECTED BY: D. J. KAIN DATE: 9.7.1984  
 AUTHORITY: C. M. A. FIELD BOOK: 1952

Station Diagram  
 215° 252M Mould advise Lining only.  
 106° - 104 M Lining only and only  
 if absolutely necessary.  
 Timber is very extensive on hill and on  
 Estimate of time to clear from 252° 60M  
 end from 104° - 215M. 3-4 days - 2 Men  
 with Chain Saws.

**BIG HILL**  
 (Rock Caen)  
 Near Core Vanes  
 ON GROUND.

320 310 300 290 280 270 260 250 240 230 220  
 330 340 350 360 370 380 390 400 410 420 430 440 450

Not to Scale  
 North

