

CENTRAL MAPPING AUTHORITY

GEODETIC SURVEY OF N.S.W.

GEODETIC STATION RECONNAISSANCE and MAINTENANCE REPORT

Description:

1. Cleared by lanes bearing *S. 117.0°/100.0m* by *W. Miller* from Trig. Mast  
*Note: Cross out word or words which do not apply*
2. Mast & Vanes have been painted white & black respectively.
3. The station/pillar was unpiled/not unpiled/constructed on *19.0000* m, dimensions now being:

Description of mark *19.0000* m should be explicit, e.g., S/Steel Pillar Plate, Steel plug, Brass plug, Bolt, G.I. Pipe

Height of mark *19.0000* m, above/below rock/concrete; Mark is *19.0000* m, above/below G.L.

Height of Top Vanes to Top Mark/Pillar plate *19.0000* m. Diameter of Vanes (vertical) *19.0000* m.

Height of Cairn *19.0000* m. Diameter of Cairn *19.0000* m. Name Plate found/not found/placed.

Length of Mast *19.0000* m. (approximate if not unpiled)

4. A *19.0000* m set in conc/rock has been placed/found, bearing *19.0000* ° M from Mast/Plug/Pillar

5. A *19.0000* m set in conc/rock has been placed/found, bearing *19.0000* ° M from Mast/Plug/Pillar

6. A *19.0000* m set in conc/rock has been placed/found, bearing *19.0000* ° M from Mast/Plug/Pillar

7. A *19.0000* m set in conc/rock has been placed/found, bearing *19.0000* ° M from Mast/Plug/Pillar

8. Action required: *None*

STANDPOINT:

STANDPOINT:

Mark	Direction	Horiz. Distance	Height Difference	Mark	Direction	Horiz. Distance	Height Difference
			above standpt.				above standpt.
			below standpt.				below standpt.
			above standpt.				above standpt.
			below standpt.				below standpt.
Prepared by: *W. Miller* 1-2-80. Checked: *W. Miller*

Noted on U.T.M. Card

Sr: 2733-1


STATION: **BIMLOW** No.: **930**  
 MAPSHEET SCALE 1:250 000 **SYDNEY**  
 INSPECTED BY: **W. MILLER K HADDON** DATE: **25-1-80**  
 AUTHORITY: **CMA** FIELD BOOK:

Station Diagram  
 North  
 Not to Scale  
*Aerial inspection from helicopter*  
*CARR ROLE & DISCS*  
*Paint still on mast & vanes*

STATION **BIMLOW** **930**

Owner's Name: *M. N. S. D.B.* Current Occupant: .....  
 Address: .....  
 Phone: *Warragamba* Phone: .....  
 ACCESS  
 Access Report of *1968* was found suitable/unsuitable. **25-1-80**

*SEE TRIG CARD.*

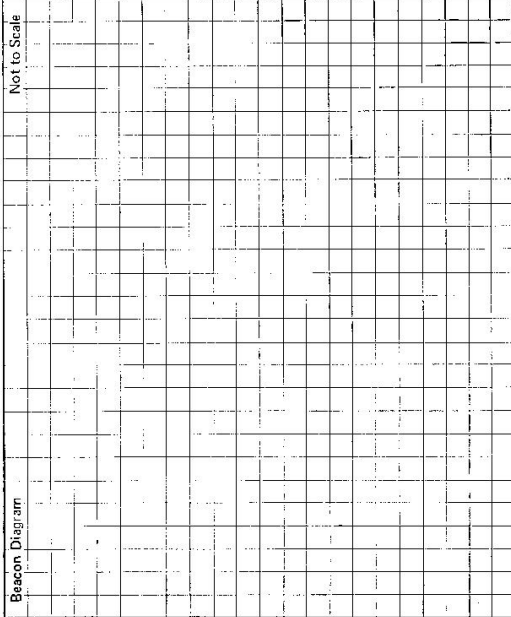

This section to be completed by officer constructing pillar.

Original station mark found/not found.

Description of mark: .....

Original beacon found/not found.

Description of beacon: .....

Height Top of Vanes to Top Mark.....m.

Height of mark.....m. above rock/conc.....m. below G.L.

Diameter of Vanes .....m. Height of Cairn .....m.

Original Beacon has/has not been destroyed by me.

Date	Record of Station
<i>25-1-80</i>	<i>Aerial inspection by helicopter</i>