

RECONNAISSANCE and MAINTENANCE REPORT

7-4-98
STATION BINDOGANDRI * 935


This Trig. Station has been:-

1. Completely cleared to permit 360° vision to surrounding Trigs.
2. Cleared by lanes bearing..... from Trig. Mast
3. Trig. Mast & Vanes have been painted white & black respectively.
4. The Trig. was unpiled/not unpiled, dimensions now being:
 - Description of mark..... should be explicit, e.g. Steel plug, Brass plug, Bolt, G.I. Pipe
 - Height of mark..... m above rock/concrete..... m below G.L.
 - Height of Top Vanes to Top Mark..... m. Diameter of Cairn..... m.
 - Height of Cairn..... m. Diameter of Cairn..... m.
 - Length of Mast..... m. (approximate if not unpiled)
5. A..... set in conc/rock has been placed..... m. bearing.....°M from Trig. Mast
6. A..... set in conc/soil has been placed..... m. bearing.....°M from Trig. Mast
7. A..... set in conc/soil has been placed..... m. bearing.....°M from Trig. Mast
8. A..... set in conc/rock has been placed..... m. bearing.....°M from Trig. Mast
9. Connection..... to..... m. bearing.....°M
10. Connection..... to..... m. bearing.....°M
11. Connection..... to..... m. bearing.....°M
12. Connection..... to..... m. bearing.....°M
13. Diff. Ht. is..... m. above
14. Diff. Ht. is..... m. below
15. Diff. Ht. is..... m. above
16. Diff. Ht. is..... m. below

Note: Cross out word or words which do not apply

Co: ASHBURNHAM
Map Sheet: PARKES
Inspected by: N. MORTON
Authority: Not to Scale

Ph: BINDOGANDRI
No: 6531 14W
Date: OCTOBER 1977
Field Book:

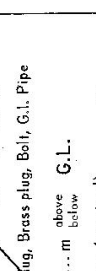

Mast destroyed
Cairn found partly intact
360° Clearing required

Date	Record of Station

Prepared by: Morton 9/11/77 Checked: Noted on U.T.M. Card

935

STATION BINDOGANDRI

Current Occupant.....


Address.....

Owners Name.....

Address.....

Access 10-77

Station Diagram

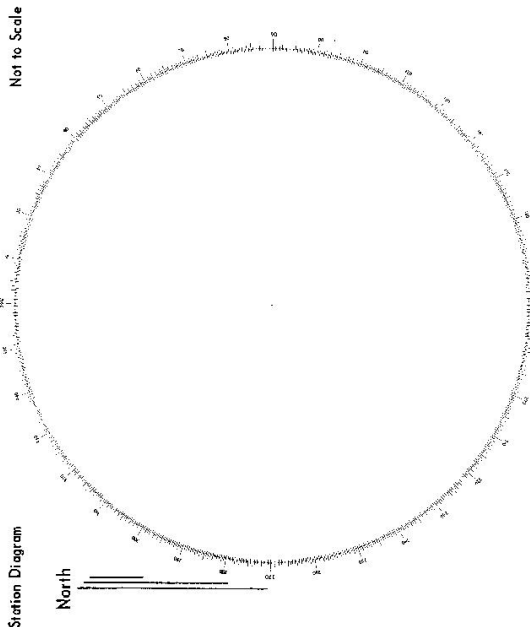

List of Observed Directions:-

Standpoint:		Standpoint:	
Station	Direction	Station	Direction
Station	Direction	Station	Direction

