

CENTRAL MAPPING AUTHORITY

GEODETIC SURVEY OF N.S.W.
 GEODETIC STATION RECONNAISSANCE and MAINTENANCE REPORT

Description:

Note: *Cross out word or words which do not apply*

1. Cleared by lanes bearing..... from Trig. Mast
2. Mast & Vanes have been painted white & black respectively.
3. The station/~~has been re-established~~/not unplied/~~has been re-established~~.....~~1.5~~.....~~19.2~~..... dimensions now being:
 Description of mark.....should be explicit, e.g., S/Steel Pillar Plate, Steel plug, Brass plug, Bolt, G.I. Pipe
 Height of mark.....m. ^{above} _{below} rock/concrete; Mark ism. ^{above} _{below} G.L.
 Height of Top Vanes to Top Mark/Pillar platem. Diameter of Vanes (vertical).....1.0.....m.
 Height of Cairn.....2.0.....m. Diameter of Cairn.....1.5.....m. Name Plate ~~XXXXXX~~/not found/~~XXXXXX~~
- Length of Mastm. (approximate if not unplied)
4. A.....SSM.....set in conc/rock has been ~~placed~~/found, bearing...20.1...°M from Mast/~~XXXXXX~~
5. A.....set in conc/rock has been placed/found, bearing.....°M from Mast/Plug/Pillar
6. A.....set in conc/rock has been placed/found, bearing.....°M from Mast/Plug/Pillar
7. A.....set in conc/rock has been placed/found, bearing.....°M from Mast/Plug/Pillar
8. Action required:.....

STANDPOINT:


Mark	Direction	Horiz. Distance	Height Difference	Mark	Direction	Horiz. Distance	Height Difference
			above standpt				above standpt
			below standpt				below standpt
			above standpt				above standpt
			below standpt				below standpt

Prepared by:

Checked:

Noted on U.T.M. Card

ST 2733-1

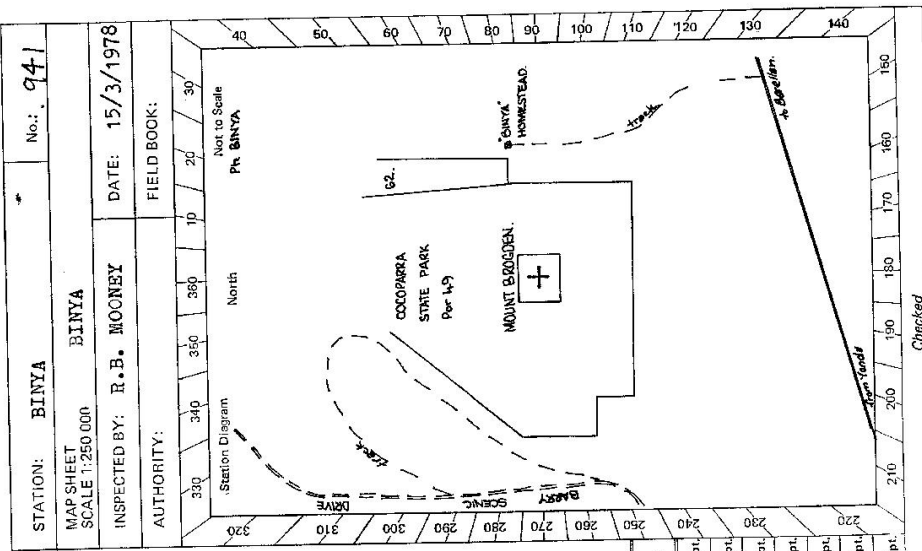

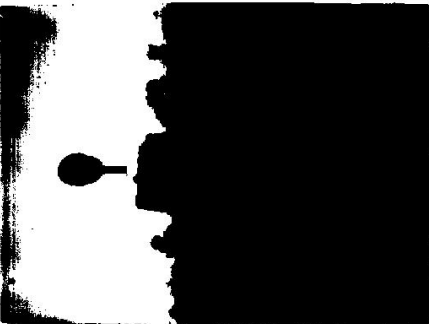STATION BINYA 941	Owner's Name: Address: Phone: Current Occupant: Address: Phone: ACCESS 15-3-1978 Access Report of 18.2/18.7 was found access /unsuitable. Binya is situated on Mount Brogden. Access is poor. From any direction an hours walk is necessary as the area is very steep and densely timbered.
Beacon Diagram Not to Scale 	This section to be completed by officer constructing pillar. Original station mark found/not found. Description of mark: Original beacon found/not found. Description of beacon: Height Top of Vanes to Top Mark.....m. above rock/cont.....m. below G.L. Height of mark.....m. below Diameter of Vanes.....m. Height of Cairn.....m. Original Beacon has/not been destroyed by me.
Date	Record of Station