

TS-103

Department of Lands

Integration of N.S.W. RECONNAISSANCE and MAINTENANCE REPORT 949

STATION **BISHOP** **PILLAR 949**

Co. **Northumberland** Ph: **Headon**

Map Sheet: **CESSNOCK** No: **01325**

Inspected by: **R.M. BEST** Date: **23-3-76**

Authority: **S.D. Newcastle** Field Book: **32B**

Beacon Diagram

Date _____ Record of Station _____

This Trig. Station has been:-

1. Completely cleared to permit 360° vision to surrounding Trigs. ✓

2. Cleared by ~~lines bearing~~ **from Trig. Mast**

3. Trig. Mast & Vanes have been painted white & black respectively. ✓

4. The Trig. was unpiled/~~replaced~~, dimensions now being:

Description of mark: **Concrete pillar** should be explicit, e.g. Steel plug, Brass plug, Bolt, Concrete Pillar

Height of ~~mark~~ **pillar** ^{above} ~~rock concrete~~ **rock concrete** _{to G.L.} **1.335** m

Height of Top Vanes to ~~Top pillar plate~~ **Top pillar plate** **1.28** m Diameter of Vanes (vertical) **0.75** m.

Height of ~~mark~~ **pillar** ^{above} ~~rock concrete~~ **rock concrete** _{to G.L.} **1.335** m. Diameter of Cairn m.

Length of Mast **2.07** m. (approximate if not unpiled)

5. A **S.S. pin** set in conc/~~rock~~ has been ~~placed~~/**fd** **3.05** m. bearing **280** °M from Trig. ~~West~~/**West** pillar

6. A **G.I.P.** set in conc/~~rock~~ has been ~~placed~~/**fd** **2.682** m. bearing **317** °M from Trig. ~~West~~/**West** pillar

7. A **C.S.** set in conc/~~rock~~ has been ~~placed~~/**fd** **2.526** m. bearing **2** °M from Trig. ~~West~~/**West** pillar

8. A **S.S.M.** set in conc/~~rock~~ has been ~~placed~~/**fd** **1.593** m. bearing **237** °M from Trig. ~~West~~/**West** pillar

9. Connection **S.S. pin** to **G.I.P.** **1.861** m. bearing **40** °M

10. Connection **S.S. pin** to **C.S.** **3.55** m. bearing **56** °M

11. Connection **S.S. pin** to **SSM** **2.194** m. bearing **130** °M

12. Connection to m. bearing °M

13. Diff. Ht. **Pillar Plate** is **1.408** m. ^{above} ~~below~~ **SSM**

14. Diff. Ht. **Pillar Plate** is **1.585** m. ^{above} ~~below~~ **S.S. pin**

15. Diff. Ht. **Pillar Plate** is **1.455** m. ^{above} ~~below~~ **G.I.P.**

16. Diff. Ht. **Pillar Plate** is **1.432** m. ^{above} ~~below~~ **C.S.**


Prepared by: **[Signature]** Checked: **Allan Borrowers**

STATION BISHOP PILLAR 949

Owners Name:
 Current Occupant:
 Address:
 Address:

- Access 23-3-76
 Km. Feature.
 0.0 Kurri Kurri P.D. - Travel toward Cadomack
 2.45 Turn Right at Government Rd.
 7.0 Frame Drive (Straight ahead)
 8.5 T' Itsm. turn right.
 9.45 Greta Turn-off - go left.
 11.2 Through gate at right angle bend.
 11.5 Gate.
 11.55 Gate - cross paddock to west side of cattle yards.
 11.7 Gate.
 12.0 Trig.

(Station Wagon access in dry conditions.)

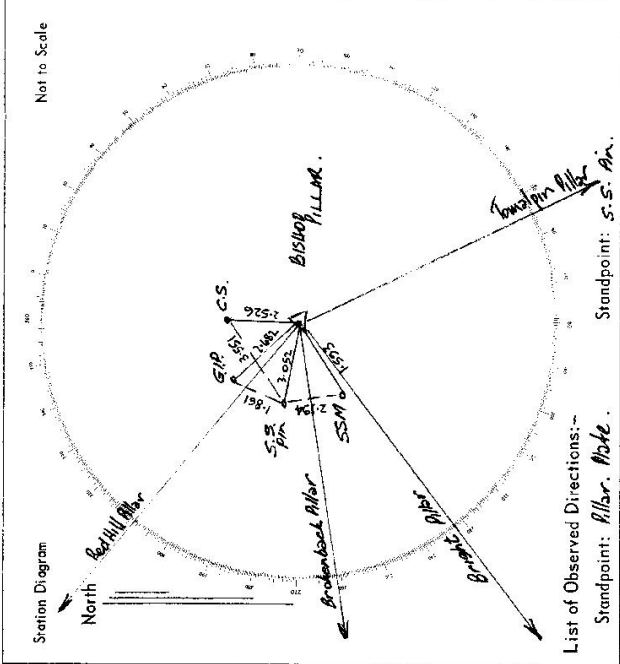

List of Observed Directions:-

Station	Direction	Station	Direction
Bright Pillar	0° 00' 00"	Bright Pillar	0° 00' 00"
S.S.M	3° 13' 08"	Red Hill Pillar	77° 29' 08"
Brokenback Pillar	27° 51' 09"	G.I.P	186° 17' 58"
S.S. Pillar	46° 54' 43"	C.S.	182° 47' 33"
Red Hill Pillar	77° 27' 49"	Pillar	226° 53' 30"
G.I.P	84° 06' 07"	Station	Direction
C.S.	125° 26' 23"	G.I.P	256° 57' 14"
Tomahorn Pillar	287° 46' 05"		

GEODETTIC SURVEY OF M.S.W.

CENTRAL MAPPING AUTHORITY

GEODETTIC STATION RECONNAISSANCE and MAINTENANCE REPORT

Description:

1. Cleared by lanes bearing. Estimated time to clear original station from Trig. Mast
2 hours Small rectangular area to scrub
2. Mast & Vanes have been painted white & black respectively.
Inspected Mast or Vanes were replaced
3. The station/pillar was replaced on 12 April. 19.79 dimensions now being:
St. Steel Cap Subs were fixed to pillar plate
4. Description of mark. S.S. Pillar should be explicit, e.g., S/Steel Pillar Plate, Steel plug, Brass plug, Bolt, G.I. Pipe
Height of mark. 1.360 m. above concrete; Mark is G.L.
5. Height of Top Vanes to Top Mast/Pillar plate 1.450 m. Diameter of Vanes (vertical) 0.600 m.
6. Height of Cairn. 1.540 m. Diameter of Cairn 0.600 m. Name Plate (found/~~not found~~/placed) C.M.A. Geodetic Station
7. Length of Mast 1.540 m. (approximate - not measured) Bishops Hill T.S. 1972
8. A S.S.M set in conc/~~rock~~ has been placed/found, bearing 280 °M from Mast/Plug/Pillar
9. A S.S.M set in conc/~~rock~~ has been replaced/found, bearing 236 °M from Mast/Plug/Pillar
10. A S.S.M set in conc/~~rock~~ has been replaced/found, bearing 322 °M from Mast/Plug/Pillar
11. A S.S.M set in conc/~~rock~~ has been placed/found, bearing °M from Mast/Plug/Pillar

STANDPOINT:

Mark	Direction	Horiz. Distance	Height Difference	Mark	Direction	Horiz. Distance	Height Difference
			above standpt.				above standpt.
			below				below
			above standpt.				above standpt.
			below				below
Prepared by:

Checked:

Noted on U.T.M. Card

STATION: Bishops Hill (Pillar) No.: 949
 MAP SHEET SCALE 1:250 000
 INSPECTED BY: J.J. Kua DATE: 12 April 1979
 AUTHORITY: C.M.A. FIELD BOOK: 1673


North

Not to Scale

Checked

St 2733-2 D. West, Government Printer

Beacon Diagram

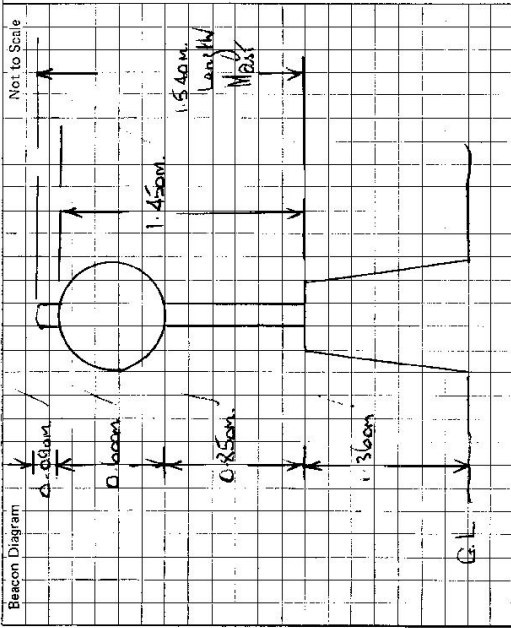

This section to be completed by officer constructing pillar.

Original station mark found/not found.

Description of mark:

Original beacon found/not found.

Description of beacon:

Height Top of Vanes to Top Mark:m.

Height of mark:m. above rock/conem. below G.L.

Diameter of Vanes:m.

Original Beacon has/has not been destroyed by me.

STATION

ශ්‍රී ලංකා විදුලි විද්‍යා සේවය (ඊ.වි.සේ.) 949

Owner's Name:
 Address:
 Phone:

Current Occupant:
 Address:
 Phone:

ACCESS

Access Report of 12.4.1978 was found suitable/unsuitable.

Date

Record of Station

949 | STATION T.S. BISHOPS [P]

PROVISIONAL VALUES

AUSTRALIAN MAP GRID		INTEGRATED SURVEYS GRID	
METRES		METRES	
ZONE	CM.	ZONE	CM.
E	N	F	N

Provisional Height m(A.H.D.); Agency

HISTORY OF STATION

Date	Record of Field Action Marking and Description of Station	Reference
6/26	MARK INSPECTED - (NEW ACCESS MARKING)	26/32

ACCESS DIAGRAM

FEATURE

- KM 0.0 - KUARA POST OFFICE - TRAVEL TOWARDS GAETA.
- 0.7 - ROUNDABOUT - STRAIGHT THROUGH (GAETA - MITCHELL AVE.)
- 2.24 - TURN RIGHT AT GOVERNMENT RD 'T' INTERSECTION.
- 7.25 - TURN RIGHT AT HAYLAND RD 'T' INTERSECTION (TO GAETA.)
- 8.23 - TURN LEFT TO GAETA.
- 9.9 - TURN LEFT AT DIRT DRIVE ACCESS AS ROAD BENDS LEFT
40mca STRAIGHT.
- 10.02 - CROSS CATTLE GRID.
- 10.36 - CROSS CATTLE GRID.
- 10.48 - CROSS PADDOCK TO WESTSIDE OF CATTLE YARDS.
- 10.7 - VEER LEFT TO TRIG.

CONVENTIONAL VEHICLE ACCESS CAN BE ACHIEVED.