

RECONNAISSANCE and MAINTENANCE REPORT

STATION **BLACKBURN G.S.** 954

This Trig. Station has been:-

Note: Cross out word or words which do not apply

1. ~~Completely cleared to permit 360° vision to surrounding Trig.~~
2. Cleared by lanes bearing 303° ~~to~~ 310° M from Trig. Mast
3. Trig. Mast & Vanes have been painted white & black respectively.
4. The Trig. was ~~unpiled~~/not unpiled, dimensions now being:

Description of mark..... should be explicit, e.g. Steel plug, Brass plug, Bolt, G.I. Pipe

Height of mark..... m <sup>above</sup> rock/concrete..... m <sup>below</sup> G.L.

Height of Top Vanes to Top Mark..... m. Diameter of Vanes (vertical) 0.70 m.

Height of Cairn 1.6m m. Diameter of Cairn 2.5m m.

Length of Mast 3.3m m. (approximate if not unpiled)

5. A..... set in conc./rock has been placed..... m, bearing.....°M from Trig. Mast
6. A. G.I. PIPE set in ~~conc~~/soil has been placed 2.24 m, bearing 262° M from Trig. Mast
7. A..... set in conc./soil has been placed..... m, bearing.....°M from Trig. Mast
8. A..... set in conc./rock has been placed..... m, bearing.....°M from Trig. Mast

9. Connection..... to..... m, bearing.....°M

10. Connection..... to..... m, bearing.....°M

11. Connection..... to..... m, bearing.....°M

12. Connection..... to..... m, bearing.....°M

13. Diff. Ht. G.I. PIPE PLACED is 2.53 m. <sup>above</sup> BOTTOM OF VANES BLACKBURN G.S. <sub>below</sub>

14. Diff. Ht. .... is..... m. <sup>above</sup> <sub>below</sub>

15. Diff. Ht. .... is..... m. <sup>above</sup> <sub>below</sub>

16. Diff. Ht. .... is..... m. <sup>above</sup> <sub>below</sub>

Prepared by: Alan Woodnuff Checked: Jeff Brown 19-5-77 Noted on U.T.M. Card


Co: \_\_\_\_\_ Ph: \_\_\_\_\_

Map Sheet: NUMBLA 1:100,000 No: \_\_\_\_\_

Inspected by: W. MILLER, R. LANDER. Date: 3rd February 77

Authority CENTRAL MAPPING Field Book: 1536

Beacon Diagram Not to Scale

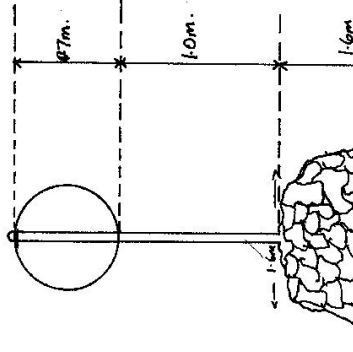

Date

BLACKBURN G.S. is in dense wood and will not become an effective trig until extensive clearing is undertaken. The forestry is under the control of the Forestry Commission thus previous could occur.

Checked

