

CENTRAL MAPPING AUTHORITY

GEODETIC SURVEY OF N.S.W.


GEODETIC STATION RECONNAISSANCE and MAINTENANCE REPORT

STATION: BLACK COOLA No.: 957

MAP SHEET SCALE 1:250 000 SYDNEY

INSPECTED BY: W. MILLER KADDON DATE: 25.1.80

AUTHORITY: C.M.A. FIELD BOOK:

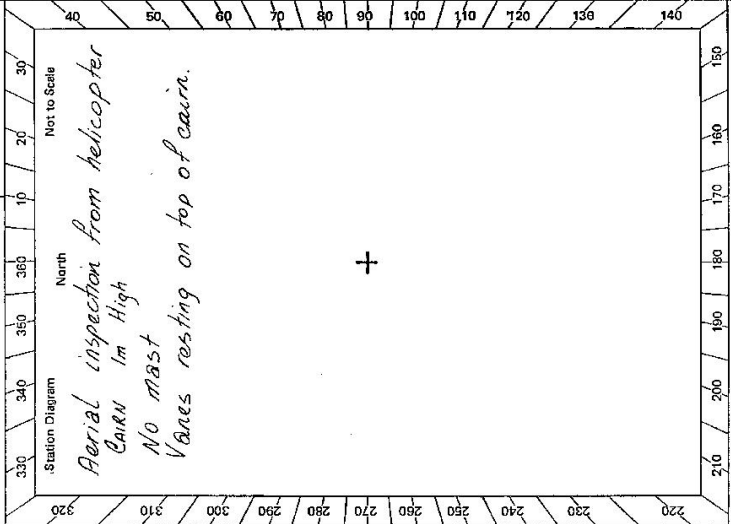

- Description: *Note: Cross out word or words which do not apply*
- Cleared by *lines-bearing. Many trees... included. Vision to N.E. from Trig. Mast*
 - Mast & Vanes have been painted white & black respectively.
 - The station/pillar was unpiled/not unpiled/constructed on 19 dimensions now being: Description of mark should be explicit, e.g., S/Steel Pillar Plate, Steel plug, Brass plug, Bolt, G.I. Pipe
- Height of mark m. ^{above} rock/concrete; Mark is m. ^{above} below G.L.
- Height of Top Vanes to Top Mark/Pillar plate m. Diameter of Vanes (vertical) m.
- Height of Cairn m. Diameter of Cairn m. Name Plate found/not found/placed.
- Length of Mast m. (approximate if not unpiled)
- A set in conc/rock has been placed/found, bearing ° M from Mast/Plug/Pillar
 - A set in conc/rock has been placed/found, bearing ° M from Mast/Plug/Pillar
 - A set in conc/rock has been placed/found, bearing ° M from Mast/Plug/Pillar
 - A set in conc/rock has been placed/found, bearing ° M from Mast/Plug/Pillar
8. Action required:

STANDPOINT:

Mark	Direction	Horiz. Distance	Height Difference	Mark	Direction	Horiz. Distance	Height Difference
			above standpt				above standpt
			below standpt				below standpt
			above standpt				above standpt
			below standpt				below standpt
			above standpt				above standpt
			below standpt				below standpt
			above standpt				above standpt
			below standpt				below standpt

Prepared by: W. MILLER 1.2.80


Checked: *W. Miller*

Noted on U.T.M. Card

Checked

SI 2733-2 D. West, Government Printer

Beacon Diagram Not to Scale

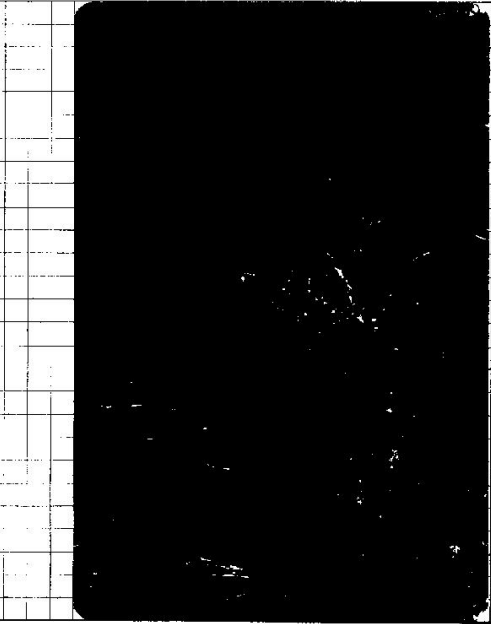

This section to be completed by officer constructing pillar.

Original station mark found/not found.

Description of mark:

Original beacon found/not found.

Description of beacon:

Height Top of Vane to Top Mark.....m.

Height of mark.....m. above G.L. below

Diameter of Vane.....m. Height of Cairn.....m.

Original Beacon has/had not been destroyed by ms.

STATION

BLACK COOLA

957

Owner's Name: M.W.S.A.D.B.

Address: Warragamba

Phone:

Current Occupant:

Address:

Phone:

ACCESS

Access Report of 25.1.1980 was found suitable/unsuitable.

SEE BINLON 1:31600 map or 1:25000 map if printed
No suggested access

Date

25.1.80 Aerial inspection from helicopter

Record of Station