

7-4-98

CENTRAL MAPPING AUTHORITY

Trigonometrical Survey of N.S.W.

Department of Lands

RECONNAISSANCE and MAINTENANCE REPORT

STATION **BLACKFELLOW**

958

This Trig. Station has been:-

Note: Cross out word or words which do not apply

1. Completely cleared to permit 360° vision to surrounding Trigs. ✓
2. Cleared by lanes bearing..... from Trig. Mast
3. Trig. Mast & Vanes have been painted white & black respectively.
4. The Trig. was unpiled/not unpiled, dimensions now being:
 - Description of mark..... should be explicit, e.g. Steel plug, Brass plug, Bolt, G.I. Pipe
 - Height of mark..... m above below rock/concrete..... m above below G.L.
 - Height of Top Vanes to Top Mark..... m. Diameter of Vanes (vertical)..... m.
 - Height of Cairn..... m. Diameter of Cairn..... m.
 - Length of Mast..... m. (approximate if not unpiled)
5. A..... set in conc/rock has been placed..... m. bearing..... °M from Trig. Mast
6. A..... set in conc/soil has been placed..... m. bearing..... °M from Trig. Mast
7. A..... set in conc/soil has been placed..... m. bearing..... °M from Trig. Mast
8. A..... set in conc/rock has been placed..... m. bearing..... °M from Trig. Mast
9. Connection..... to..... m. bearing..... °M
10. Connection..... to..... m. bearing..... °M
11. Connection..... to..... m. bearing..... °M
12. Connection..... to..... m. bearing..... °M
13. Diff. Ht. is..... m. above below
14. Diff. Ht. is..... m. above below
15. Diff. Ht. is..... m. above below
16. Diff. Ht. is..... m. above below


Co: **GLUCESTER** Ph: **BARSTER**

Map Sheet: **FARSTER** No: **S433**

Inspected by: **M.L. Morrison** Date: **21-10-77**

Authority..... Field Book: **1561**

Beacon Diagram..... Not to Scale

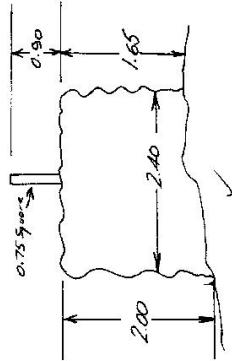

Date	Record of Station
	<i>TRIG. ST. NO MARKS (HAS BEEN REPAIRED) MUST OK NO OTHER MARKS PD</i>
	<i>No clearing required</i>

Prepared by: *[Signature]* Checked: *[Signature]* Noted on U.T.M. Card

