

CENTRAL MAPPING AUTHORITY

GEODETIC SURVEY OF N.S.W.

GEODETIC STATION RECONNAISSANCE and MAINTENANCE REPORT

- Description: *Note: Cross out word or words which do not apply*
- Cleared by lanes bearing..... from Trig. Mast
  - Mast & Vanes have been painted white & black respectively.
  - The station/pillar was unpiled/not unpiled/constructed on..... 19....., dimensions now being: Description of mark..... should be explicit, e.g., S/Steel Pillar Plate, Steel plug, Brass plug, Bolt, G.I. Pipe  
Height of mark.....m, above below rock/concrete; Mark is.....m, above below G.L.  
Height of Top Vanes to Top Mark/Pillar plate.....m. Diameter of Vanes (vertical).....m.  
Height of Cairn.....m. Diameter of Cairn.....m. Name Plate found/not found/placed.  
Length of Mast.....m. (approximate if not unpiled)
  - A..... set in conc/rock has been placed/found, bearing.....° M from Mast/Plug/Pillar
  - A..... set in conc/rock has been placed/found, bearing.....° M from Mast/Plug/Pillar
  - A..... set in conc/rock has been placed/found, bearing.....° M from Mast/Plug/Pillar
  - A..... set in conc/rock has been placed/found, bearing.....° M from Mast/Plug/Pillar
  - Action required:.....

STANDPOINT:


Mark	Direction	Horiz. Distance	Height Difference	Mark	Direction	Horiz. Distance	Height Difference
			above standpt.				below standpt.
			below standpt.				above standpt.
			above standpt.				below standpt.
			below standpt.				above standpt.
			above standpt.				below standpt.
			below standpt.				above standpt.
			above standpt.				below standpt.
			below standpt.				above standpt.

Prepared by:

Checked: *[Signature]*

Noted on U.T.M. Card

Sr 2733-1

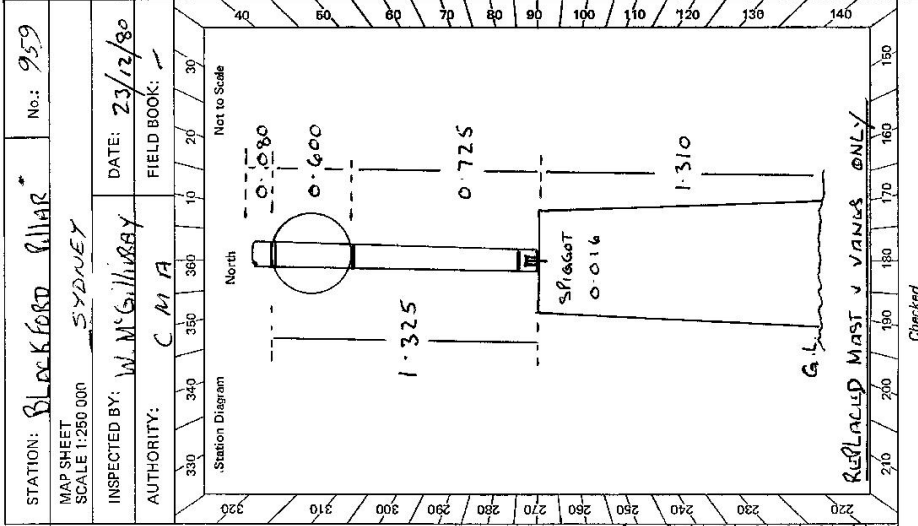

Checked


STATION: **BLACKFORD PILLAR** No: **959**

MAP SHEET SCALE 1:250 000

INSPECTED BY: **W.M. GILLIBAY**

DATE: **23/12/80**

AUTHORITY: **CMA** FIELD BOOK: **-**

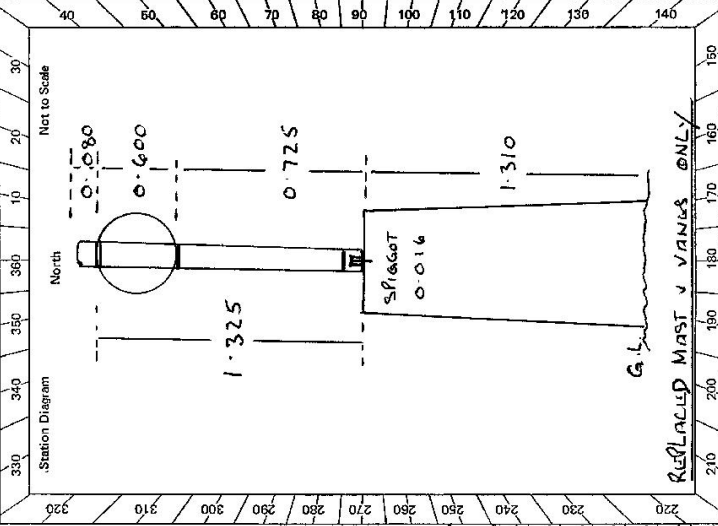



CENTRAL MAPPING AUTHORITY

GEODETIC SURVEY OF A.S.M.

GEODETIC STATION RECONNAISSANCE and MAINTENANCE REPORT

STATION: **BLACKFORD** No.: **959**

MAP SHEETS SCALE 1:250 000

INSPECTED BY: **R. ELLIS** DATE: **19/2/87**

AUTHORITY: **C.M.A.** FIELD BOOK:

Description: **360°** Note: Cross out word or words which do not apply

1. Cleared by lanes bearing..... from Trig. Mast

2. Mast & Vanes have been painted white & black respectively.

3. The station/pillar was unpiled/not unpiled/constructed on..... dimensions now being:

Description of mark..... should be explicit, e.g., S/Steel Pillar Plate, Steel plug, Brass plug, Bolt, G.I. Pipe

Height of mark..... m. above rock/concrete. mark is..... m. above G.L.

Height of Top Vanes to Top Mark/Pillar plate..... m. Diameter of Vanes (vertical).....m.

Height of Cairn..... m. Diameter of Cairn..... m. Name Plate found/not found/placed.

Length of Mast..... m. Approximate if not unpiled)


4. A..... set in conc/rock Has been placed/found, bearing.....°M from Mast/Plug/Pillar

5. A..... set in conc/rock Has been placed/found, bearing.....°M from Mast/Plug/Pillar

6. A..... set in conc/rock Has been placed/found, bearing.....°M from Mast/Plug/Pillar

7. A..... set in conc/rock Has been placed/found, bearing.....°M from Mast/Plug/Pillar

8. Action required:.....

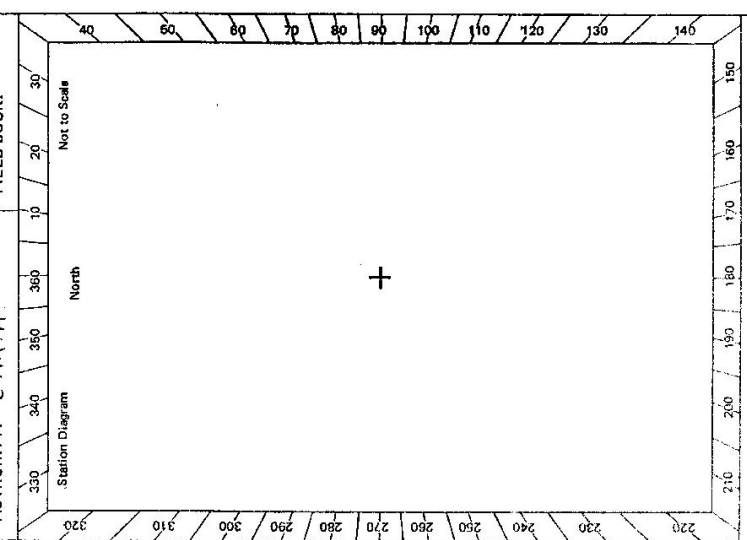

STANDPOINT:

Mark	Direction	Horiz. Distance	Height Difference	Mark	Direction	Horiz. Distance	Height Difference
			above standpt.				below standpt.
			below standpt.				above standpt.
			above standpt.				below standpt.
			below standpt.				above standpt.
Prepared by: *[Signature]*

Checked: *[Signature]*

Noted on U.T.M. Card

Checked

GS 24

Beacon Diagram: <span style="float: right;">Not to Scale</span>	<p style="text-align: center;">STATION <b>BLACKFORD</b> <b>959</b></p> <p>Owner's Name: <b>ROBERT HEATH</b>                  Address: <b>LOT 17, LUSSENHAM RD, LUSSENHAM, (047) 73 4452</b>                  Phone: <b>9-2-1987</b>                  Access: <b>19-2-1987</b></p> <p>Current Occupant:                  Address:                  Phone:</p> <p>Access Report of: <b>TS</b> was found suitable/unsuitable.</p> <p style="text-align: center;"><i>Owner not contacted on reconnaissance.</i></p> <p style="text-align: center; font-size: 1.2em;"><i>It is not proposed to replace this station</i></p> <p style="text-align: right; font-size: 1.2em;"><i>20.2.87</i></p>
Pillar, Mast & Vanes as well as all reference marks have been bulldozed off the hill top and can be found on the side of the hill. Presumed to have been done by present owner.	This section to be completed by officer constructing pillar. Original station mark found/not found. Description of mark: Original beacon found/not found. Description of beacon: Height Top of Vanes to Top Mark .....m. Height of mark .....m. above G.L. below rock/conc. Diameter of Vanes .....m. Height of Cairn .....m. Original Beacon has/has not been destroyed by me.
Date	Record of Station