
74-88	PORT STATION BLACK JACK 966	Co: Salwyn Phi: Round Hill	W. N. D. Banga Date: 27. Cantral Mapping Elely Bog	<u> </u>	Black		(Approx)					5.65	<i>→</i>		Date Record of Station	8					Checked
Trigonometrical Survey of N.S.W.	RECONNAISSANCE and MAINTENANCE REPORT	Note: Gross out word or words which do not apply	vision to surrounding Trigs. from Trig. Mast	white & black respectively.	The Trig. was <del>unpited/</del> not unpited, dimensions now being: Original Spation Mark found / <del>nat found</del> Description of mark		Diameter of Vanes (vertical)m.  Diameter of Cairn m.	(approximate if not unpiled)	been placedbearing	been placedm. bearing M from Trig. Mast	been placedm. bearing M from Trig, Mast	en glezedm. bearing	J.C. m. bearing	m. bearing9M	m. bearing	m. bearing?M	S	S III. above below	S M. above	S. m. cover	Checked: Can, Cord 12/4/Noted on U.T.M. Cord
CENTRAL MAPPING AUTHORITY	Department of Lands	This Trig. Station has been:-	<ol> <li>Completely cleared to permit 360° visite Cleared by Janes bearing.</li> </ol>	3. Trig. Mast & Yanes have been painted white & black respectively.	4. The Trig. was <del>unpiled/</del> not unpiled, dimensions now being: Description of mark	Height of markmbove rock/concrete	Height of Top Vanes to Top Mark	D)	c/rock has	6. Aset in conc/soil has be	7. Aset in conc/soil has be	8. Aset in conc/rock has been glezedm. bearing	9. Connectionto	10. Connection10	11. Connectionfo	12. Connection	Ī	14. Diff. Ht.	15. Diff. Htis	16. Diff. Ht.	Prepared by: 1 La ge. C.

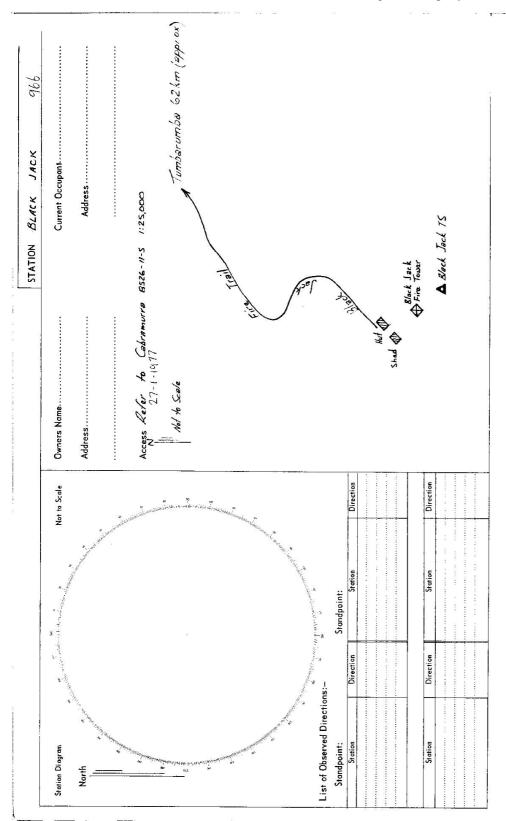

								•				
		GEODETIC STATION	GEODETIC STATION RECONNAISSANCE and MAINTENANCE REPORT	d MAINTENA	NCE REP	ORT	STATION:	BLACK	CK JACK		No.: 96	996
	Description:	Ne	Note: Cross out word or words which do not apply	ords which do	Ajdde tou	\	MAP SHEET SCALE 1:250 000		ВЕСЯ			
÷	1. Cleared by lanes bearing		from Trig. Mast	from Trig	Mast.		INSPECTED BY:		G.C.HANNA	DATE: 23	23-4-80	80
2.	Mast & Vanes have been painted white & black respectively.	white & black respectively			/		AUTHORITY:	C.M.A	1.A.	FIELD	FIELD BOOK:	
က်	The station/pillar was unpiled/not unpiled/constructed on19	t unpiled/constructed on.	79	, dimensions n	ow being:		330	340	350 360	19 / 29	6 / 30	
	Description of markshould	should be explicit, e.g.	be explicit, e.g., S/Steel Pillar Plate, Steel plug, Brass plug, Bolt, G.I. Pipe	il plug, Brass p	lug, Bolt, (	3.1, Pipe	Station Diagram	agram	North		Not to Scale	
	Height of markm. above rock/concrete;	e rock/concrete;	Mark is m. above G.L.	ow G.L.								
	Height of Top Vanes to Top Mark/Pillar plate	/Pillar plate	m. Blameter c	Diameter of Vanes (vertical)m.	cal}	.E	<u></u>					
	Height of Cairnm.		.m.	Name Plate found/not found/placed.	d/not foun	d/placed.	ié ,					
	Length of Mast	.m. (approximate if no	t unpiled)				008					_,
4	Aset, in conc/rock has been placed/found, bearing	onc/rock has been placed,	/found, bearing"	VI from Mast/	'Plug/Pillar		: /0					6/
ភេ	5. Aset in conc/pack has been placed/found, bearing	onc/pack has been placed,	/found, bearing	M from Mast/Plug/Pillar	Plug/Pillar		6ź /					<del>/p</del> \
(ri	6. Asg.ir conc/rock has been placed/found, bearing	onc/rock has been placed,	found, bearing"	V from Mast/Plug/Pillar	Plug/Pillar		280					80
~.	7. A. A. A. Beringset in conc/rock has been placed/found, bearing	onc/rock has been placed,	found, bearing"	of from Mast/	Plug/Pillar		0/2		+			
100	8. Action required:					•	097					
S	STANBPOINT:		STANDPOINT:			.3.	:\0					
1	Mark Direction Di	Horiz. Distance Height Difference	Mark	Direction	Horiz. Distance	Height Difference	, że					
		above standpt. below				above standpt.	, 240					720
		above standpt. below				above below standpt.						
		above standpt.				above below standpt.	<b>330</b>					130
		above standpt. below				above standpt, below						_
		above below standpt.				above standpt,						
		above standpt.				sbove standpt,	)टर्					46
		above standpt.	0			above standpt.	1 210 /	/ oóz	190 180	170 / 18	160 150	
١	200											

2733-2 D. West, Government Printer	STATION	BLACK JACK 966
Not	Owner's Name:	Current Occupant:
	Address:	Address
	Phone:	Phone:
	ACCESS	
	Access Report of 23.4.198. Kwas found suitable/unsuitable.	
	ACCESS See also Tombong 8624-S	M&V seen from track 4Km west of trin
		Cairn obscured by vegetation.
		Light clearing recoired.
	0.7 R.H. turn towards Currawong/Tombong.	Hell of a walk involved through bush (4-5 km)
	18.3 Road intersection - go straight ahead.	suggest access by oir.
	100	
	38.9 Take track to left.	
	23.65 The track to right.	
This section to be completed by officer construction oillar		
Original station mark found/ons found		
Original statuori nigity touriby, not fouriby.		
Description of mark:		
Original beacon found/not found.		
Description of beacon:	en de la companya de	and the state of t
	Date	Record of Station
Height Top of Vanes to Top Mark		and the first of t
Height of markm below rock/concm below G.L.		
Diameter of Vanesm.		нания принципальний при
Original Beacon has/has not been destroyed by me.	-	