

GEODETTIC SURVEY OF ALS#

CENTRAL MAPPING AUTHORITY

GEODETTIC STATION RECONNAISSANCE and MAINTENANCE REPORT

STATION: REEVES No.: 962

MAP SHEETS SCALE 1:100 000 BATHURST

SCALE 1:250 000 DBEKON

INSPECTED BY: J. SUTTON DATE: 23rd Feb. 88

AUTHORITY: CMA FIELD BOOK: —

- Description:
- Cleared by lanes bearing 32.5°M 32.5°M. Note: Cross out word or words which do not apply from Trig. Mast
 - Mast & Vanes ~~have been~~ repainted white & black respectively.
 - The station/~~pillar~~ ~~was~~ ~~unpiled~~/~~constructed~~ on 23rd Feb. 1988, dimensions now being: Description of mark..... should be explicit, e.g., S/Steel Pillar Plate, Steel plug, Brass plug, Bolt, G.I. Pipe
- Height of mark..... m. above below G.L. Mark is..... m. above below G.L.
- Height of Top Vanes to Top Mark/Pillar plate..... m. Diameter of Vanes (vertical) 1.0 m.
- Height of Cairn 0.7 m. Diameter of Cairn 1.6 m. Name Plate found/not found/placed.
- Length of Mast 3.16 m. (approximate if not unpiled)
- A S.S.M. set in conc./rock has been placed/found, bearing 140°M from Mast/~~Plug/Pillar~~
 - A G.I.Pipe set in conc./rock has been placed/found, bearing 100°M from Mast/~~Plug/Pillar~~
 - A..... set in conc./rock has been placed/found, bearing.....°M from Mast/~~Plug/Pillar~~
 - A..... set in conc./rock has been placed/found, bearing.....°M from Mast/~~Plug/Pillar~~
- Action required: Replace mast vane station clearing as necessary
Paint was and vane.

STANDPOINT:

Mark	Direction	Horiz. Distance	Height Difference	Mark	Direction	Horiz. Distance	Height Difference
			above standpt.				below standpt.
			below standpt.				above standpt.
			above standpt.				below standpt.
			below standpt.				above standpt.
Prepared by: *J. Sutton* 24-6-88 Checked: *[Signature]*

Noted on U.T.M. Card

Checked

STATION REEVES TS 968

Owner's Name
 Address:
 Phone:
 Current Occupant:
 Address:
 Phone:


ACCESS: 23rd Feb. 1988

- Access Report of 24.2.1972 was found ~~unsuitable~~ unsuitable.
 0.0 From Oberon Post Office head East towards Hampton
 1.40 At intersection proceed towards Katomba, Lithgow, Jendouh Caves
 18.90 Turn right along unsealed road 'Jendouh Caves Via Buggy Creek
 Road' and 'Jendouh State Forest'.
 19.05 At 'Y' Intersection follow road to right 'Western Boundary Road'.
 19.90 At 'Y' Intersection take road to right. At 'Y' intersection with Ridge Rd
 take road to right.
 20.40 At 'Y' intersection take road to right.
 22.30 Turn right along 'Karamina Road' and through gate.
 22.65 Track to left. Go straight ahead.
 22.80 Track to right. Go straight ahead.
 23.70 Track to left. Go straight ahead.
 23.89 Track to right. Go straight ahead.
 24.35 At 'T' intersection, turn right.
 24.50 At track intersection near yards, go straight ahead. Follow fence line.
 25.45 At Old iron gate follow track near to ridge top along fence line.
 26.10 Pass through old iron gate in fence line. Follow track through gum scrub
 26.65 Stop track on track. Trig is 150m on left on top of ridge but NORTH
 at the highest point.

512733-2 D West. Government Printer

Beacon Diagram

Not to Scale

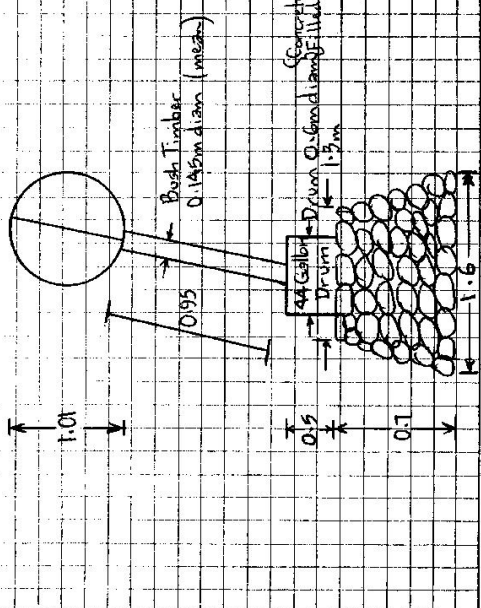

This section to be completed by officer constructing pillar.

Original station mark found/not found.

Description of mark:

Original beacon found/not found.

Description of beacon:

Height Top of Vanes to Top Markm.

Height of markm. above G.L. below

Diameter of Vanesm. Height of Calmm.

Original Beacon has/not been destroyed by mts.

Date

Record of Station