

GEODETTIC SURVEY OF N.S.W.

CENTRAL MAPPING AUTHORITY

GEODETTIC STATION RECONNAISSANCE and MAINTENANCE REPORT

STATION: *BLOOMFIELD G.S.* No.: *989*

MAP SHEET SCALE 1:250 000
INSPECTED BY: *M.L. Meehan* DATE: *18-1-79*

AUTHORITY: *C.M.A.* FIELD BOOK: *1720*


Description:
Note: *Cross out word or words which do not apply*

1. Cleared by lanes bearing..... from Trig. Mast
2. Mast & Vanes have been painted white & black respectively.
3. The station/pillar was unpiled/not unpiled/constructed on.....19....., dimensions now being:
Description of mark.....should be explicit, e.g., S/Steel Pillar Plate, Steel plug, Brass plug, Bolt, G.I. Pipe
Height of mark.....m. ^{above} rock/concrete; Mark is.....m. ^{above} G.L.
Height of Top Vanes to Top Mark/Pillar platem. Diameter of Vanes (vertical).....m.
Height of Cairn.....m. Diameter of Cairn.....m. Name Plate found/not found/placed.
Length of Mastm. (approximate if not unpiled)
4. A.....set in conc/rock has been placed/found, bearing.....°M from Mast/Plug/Pillar
5. A.....set in conc/rock has been placed/found, bearing.....°M from Mast/Plug/Pillar
6. A.....set in conc/rock has been placed/found, bearing.....°M from Mast/Plug/Pillar
7. A.....set in conc/rock has been placed/found, bearing.....°M from Mast/Plug/Pillar
8. Action required:.....

STANDPOINT:							
Mark	Direction	Horiz. Distance	Height Difference	Mark	Direction	Horiz. Distance	Height Difference
			above standpt.				above standpt.
			below standpt.				below standpt.
			above standpt.				above standpt.
			below standpt.				below standpt.
			above standpt.				above standpt.
			below standpt.				below standpt.
			above standpt.				above standpt.
			below standpt.				below standpt.

Prepared by: *[Signature]* 26/1/79. Checked: *[Signature]* Noted on U.T.M. Card

ST 2733-1

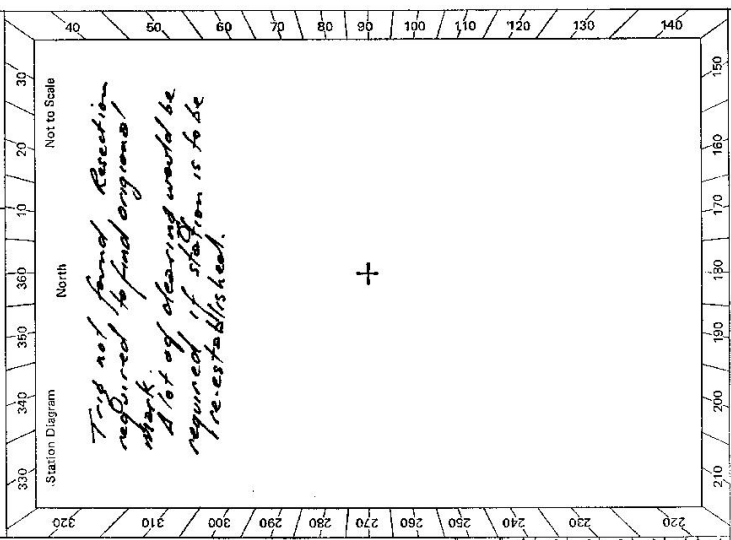

S4 2733-2 D, West, Government Printer Beacon Diagram Not to Scale 	STATION BLOOMFIELD G.S. 989 Owner's Name: Address: Phone: Current Occupant: Address: Phone:	ACCESS Access Report of 18.1.1973 was found suitable/unsuitable. Direction 0.00 Berema Rd. Head towards Moss Vale 0.80 Turn left sign Robertson Kangaroo Road 5.40 Turn left into Herbsters Road (Opp Bong Bong Reserve) 6.85 Grid sign 'MILTON PARK' 7.75 Take R.H. fork follow road through buildings around loop 8.45 Turn right into lane go through gate and head to cattle yards 8.60 Through middle of cattle yards 8.70 Gate follow track. 9.30 Through gates in double fence Turn left and make own way up hill: BEWARE OF ROCKS LINGERING IN THE GRASS 9.60 Top of hill
This section to be completed by officer constructing pillar. Original station mark found/not found. Description of mark: Original beacon found/not found. Description of beacon: Height Top of Vanes to Top Markm. Height of markm. above G.L. below rock/concm. Diameter of Vanesm. Height of Cairnm. Original Beacon has/has not been destroyed by me.		Record of Station Date