Department of Lands

Integratic urvey of N.S.W.

RECONNAISSANCE and MAINTENANCE REPORT 10104

STATION NOBBY'S LIGHTHOUSE TS 10104

This Trig. Station has been:- *Note: Cross out word or words which do not apply*

1. ✓ Completely cleared to permit 360° vision to surrounding Trigs.
2. ~~Cleared~~ by lanes bearing ..... from Trig. Mast
3. Trig. Mast & Vanes have been painted white & black respectively.
4. The Trig. was unpiled/~~not unpiled~~, dimensions now being:

   Description of mark Stainless Steel plug in conc. should be explicit, e.g. Steel plug, Brass plug, Bolt, Concrete Pillar

   Height of mark ..... m above/below rock/concrete ..... m above/below G.L.

   Height of Top Vanes to Top Mark/Top pillar plate ..... m Diameter of Vanes (vertical) ..... m.

   Height of Cairn ..... m. Diameter of Cairn ..... m.

   Length of Mast ..... m. (approximate if not unpiled)
5. A ~~Old Trig plug~~ set in conc/~~rock~~ has been ~~placed~~/fd 25.466 calc m. bearing 184 °M from Trig. ~~Mast/pillar~~
6. A ..... set in conc/soil has been placed/fd ..... m. bearing ..... °M from Trig. Mast/pillar
7. A ..... set in conc/soil has been placed/fd ..... m. bearing ..... °M from Trig. Mast/pillar
8. A ..... set in conc/rock has been placed/fd ..... m. bearing ..... °M from Trig. Mast/pillar
9. Connection ..... to ..... : ..... m. bearing ..... °M
10. Connection ..... to ..... : ..... m. bearing ..... °M
11. Connection ..... to ..... : ..... m. bearing ..... °M
12. Connection ..... to ..... : ..... m. bearing ..... °M
13. Diff. Ht. ..... is ..... m. above/below .....
14. Diff. Ht. ..... is ..... m. above/below .....
15. Diff. Ht. ..... is ..... m. above/below .....
16. Diff. Ht. ..... is ..... m. above/below .....

Co: NORTHUMBERLAND Ph: NEWCASTLE

Map Sheet: No:

Inspected by: H.G. HELSHAM Date: 21/7/71

Authority DEPT LANDS Field Book:

Beacon Diagram Not to Scale

NO BEACON

Date	Record of Station

Prepared by: [signature] Checked: [signature] 7/1/77

TS10104 | Print Date: 31/05/2022 18:27 | No Of Pages: 2 | Property of DFSI – Spatial Services

STATION TS 10104 NOBBYS LIGHTHOUSE

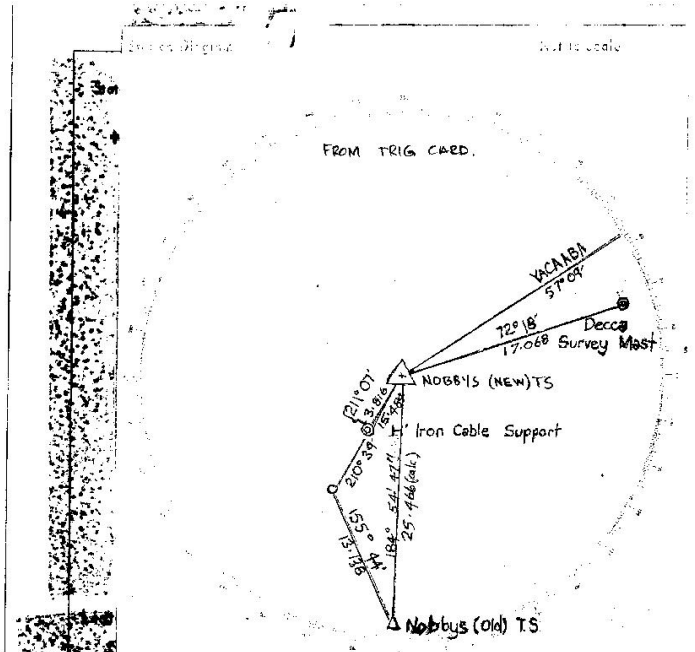

Station	Direction	Station	Direction

Station	Direction	Station	Direction

Owners Name ..... Current Occupant .....

Address ..... Address .....

Access 21-7-1971

AT NOBBYS LIGHTHOUSE, NEWCASTLE

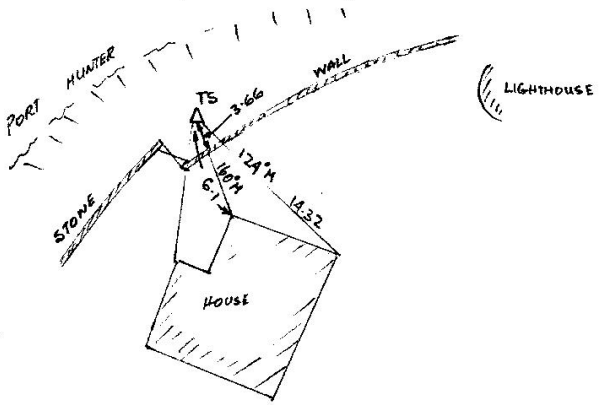

D. West, Government Printer, New South Wales – 1976

TS10104 | Print Date: 31/05/2022 18:27 | No Of Pages: 2 | Property of DFSI – Spatial Services