TS102

TS102 CMA 1-039
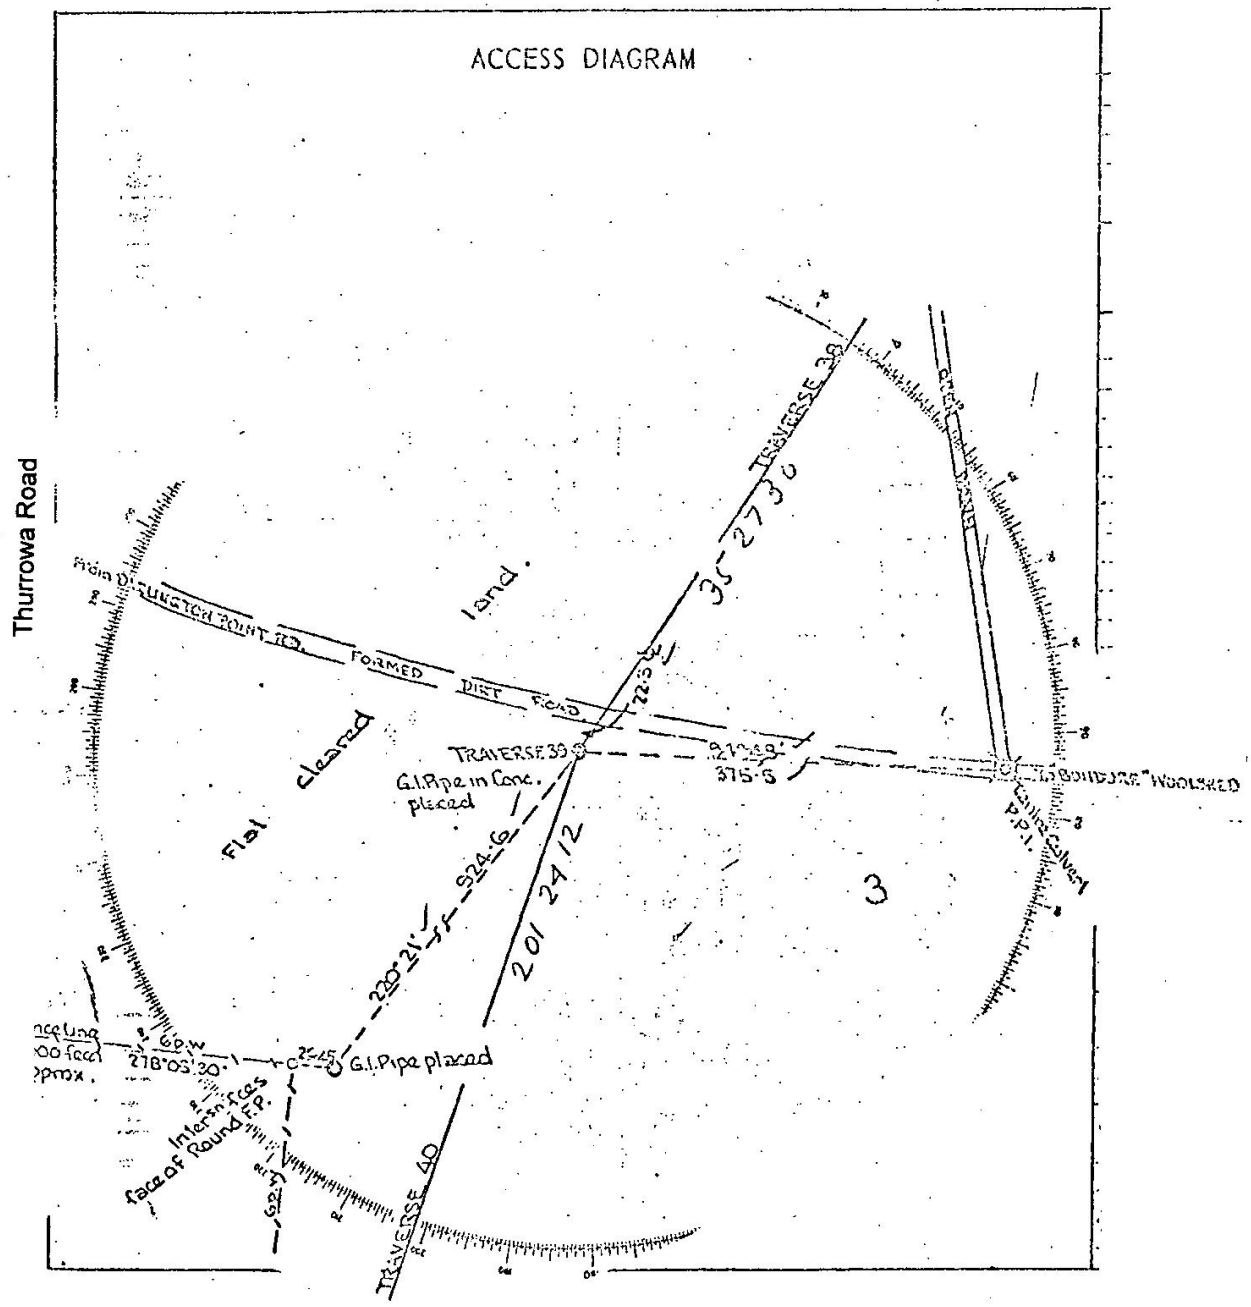
Location : **Bundure**
LGA : **Jerilderie**