Department of Lands

Integration Survey of N.S.W.

RECONNAISSANCE and MAINTENANCE REPORT 10237

STATION WARKWORTH 7 (P) TS 10237

Co: HUNTER | Ph: WARKWORTH

Map Sheet: CESSNOCK 1:100 000 | No: 9132

Inspected by: B S Collier | Date: 31-8-76

Authority Integration | Field Book: PDP 746

This Trig. Station has been:- Note: Cross out word or words which do not apply

1. Completely cleared to permit 360° vision to surrounding Trigs.
2. Cleared by lines bearing ..... from Trig. Mast
3. Trig. Mast & Vanes have been painted white & black respectively. ✓
4. The Trig. was unpiled/~~not unpiled~~, dimensions now being:

   Description of mark STEEL PILLAR should be explicit, e.g. Steel plug, Brass plug, Bolt, Concrete Pillar

   Height of mark 1·28 m above/~~below~~ ~~rock~~/concrete 1·33 m above/~~below~~ G.L.

   Height of Top Vanes to ~~Top Mark~~/Top pillar plate 1·44 m Diameter of Vanes (vertical) 0·6 m.

   Height of Cairn 1·28 m. Diameter of Cairn ..... m.

   Length of Mast 1·53 m. (approximate if not unpiled)
5. A..... set in conc/rock has been placed/fd ..... m. bearing ..... °M from Trig. Mast/pillar
6. A..... set in conc/soil has been placed/fd ..... m. bearing ..... °M from Trig. Mast/pillar
7. A..... set in conc/soil has been placed/fd ..... m. bearing ..... °M from Trig. Mast/pillar
8. A..... set in conc/rock has been placed/fd ..... m. bearing ..... °M from Trig. Mast/pillar
9. Connection ..... to ..... : ..... m. bearing ..... °M
10. Connection ..... to ..... : ..... m. bearing ..... °M
11. Connection ..... to ..... : ..... m. bearing ..... °M
12. Connection ..... to ..... : ..... m. bearing ..... °M
13. Diff. Ht. ..... is ..... m. above/below .....
14. Diff. Ht. ..... is ..... m. above/below .....
15. Diff. Ht. ..... is ..... m. above/below .....
16. Diff. Ht. ..... is ..... m. above/below .....

Prepared by: B S COLLIER Checked: F J Sullivan

Beacon Diagram Not to Scale

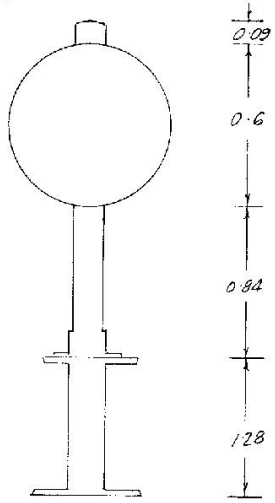

Date	Record of Station
31-8-76	PILLAR PLACED

TS10237 | Print Date: 31/05/2022 18:30 | No Of Pages: 2 | Property of DFSI – Spatial Services

STATION WARKW TH 7(P) TS 10237

Station Diagram

Not to Scale

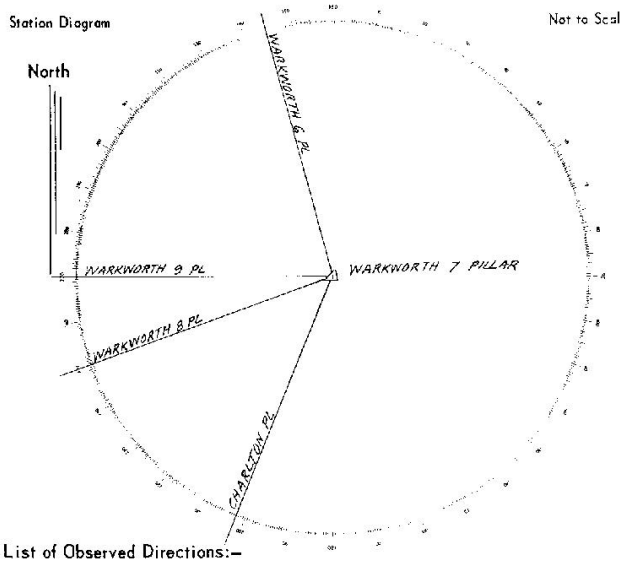

Owners Name.....

Current Occupant.....

Address.....

Address.....

.....

.....

Access 31-8-1976

TAKE PUTTY ROAD FROM SINCLETON
TRAVEL SOUTH APPROX 138 KM FROM SINGLETON AND
TURN RIGHT DOWN ~~ROAD TO WAT~~ DISUSED ROAD BESIDE STOCKYARDS
TRAVEL 200M TO PILLAR

List of Observed Directions:–

Standpoint: PILLAR

Standpoint:

Station	Direction	Station	Direction
CHARLTON PL	0° 00' 00"		
WARKWORTH 8 PL	48° 05' 32"		
WARKWORTH 9 PL	67° 51' 47.2"		
WARKWORTH 6 PL	143° 13' 40.5"		

Station	Direction	Station	Direction

D. West, Government Printer, New South Wales – 1976

TS10237 | Print Date: 31/05/2022 18:30 | No Of Pages: 2 | Property of DFSI – Spatial Services