


76-109

Department of Lands Integration Sur of N.S.W. RECONNAISSANCE and MAINTENANCE REPORT

STATION: VALE HEAD (10353)

Co: WELLSINGTON Ph: SHANBERG
 Map Sheet: 1:50,000 MOLONG No: 8631 14IV
 Inspected by: C. WATKINS Date: 12-9-80
 Authority: Telecom Field Book: (4-9)

Beacon Diagram Not to Scale

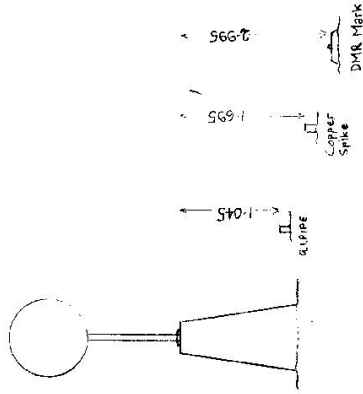

This Trig. Station has been: Note: Cross out word or words which do not apply

1. Completely cleared to permit 360° vision to surrounding Trigs.
2. Cleared by James bearing from Trig. Mast
3. Trig. Mast & Vanes have been painted white & black respectively.
4. The Trig. was unpiled/not unpiled, dimensions now being:

Description of mark: Concrete Pillar should be explicit, e.g. Steel plug, Brass plug, Bolt, Concrete Pillar

Height of mark: m above rock/concrete m below G.L.
 Height of Top Vanes to Top Mark/Top pillar plate: m Diameter of Vanes (vertical): m

Height of Conn: m Diameter of Conn: m
 Length of Mast: m (approximate if not unpiled)

5. A G.L. Pipe set in conc/rock has been placed/d 3.56 m bearing 310° M from Trig. Mast/pillar
6. A Copper Spike set in conc/soil has been placed/d 3.46 m bearing 225° M from Trig. Mast/pillar
7. A D.M.A. set in conc/soil has been placed/d 2.67 m bearing 181° M from Trig. Mast/pillar
8. A set in conc/rock has been placed/d m bearing m from Trig. Mast/pillar

9. Connection to m bearing m
10. Connection to m bearing m
11. Connection to m bearing m
12. Connection to m bearing m
13. Diff. Ht. D.M.A. Mark is 2.225 m below Pillar Plate
14. Diff. Ht. G.L. Pipe is 1.045 m below "
15. Diff. Ht. Copper Spike is 1.695 m below "
16. Diff. Ht. to m above m below

Prepared by: Checked:

Date	Record of Station

LAND INFORMATION CENTRE

GEODETIC SURVEY OF A.S.M.

GEODETIC STATION RECONNAISSANCE and MAINTENANCE REPORT

STATION: **VALE HEAD** No.: **10353**

MAP SHEET SCALE: **1:250,000** **BATHURST**


INSPECTED BY: **L. HITCHINS** DATE: **30/10/90**

AUTHORITY: **L.I.C** FIELD BOOK: **—**

Description: *Note: Cross out word or words which do not apply*

1. Cleared by lances bearing..... from Trig. Mast
2. Mast & Vanes have been painted white & black respectively.
3. The station/pillar was unpiled/not unpiled/constructed on..... 19....., dimensions now being:
 - Description of mark..... should be explicit, e.g., S/Steel Pillar Plate, Steel plug, Brass plug, Bolt, G.I. Pipe
 - Height of mark.....m. ^{above} rock/concrete; Mark is.....m. ^{above} G.L. _{below}
 - Height of Top Vanes to Top Mark/Pillar platem. Diameter of Vanes (vertical).....m.
 - Height of Cairn.....m. Diameter of Cairn.....m. Name Plate found/not found/placed.
 - Length of Mastm. (approximate if not unpiled)
4. A.....set in conc/rock has been placed/found, bearing.....° M from Mast/Plug/Pillar
5. A.....set in conc/rock has been placed/found, bearing.....° M from Mast/Plug/Pillar
6. A.....set in conc/rock has been placed/found, bearing.....° M from Mast/Plug/Pillar
7. A.....set in conc/rock has been placed/found, bearing.....° M from Mast/Plug/Pillar
8. Action required:.....

Access Only

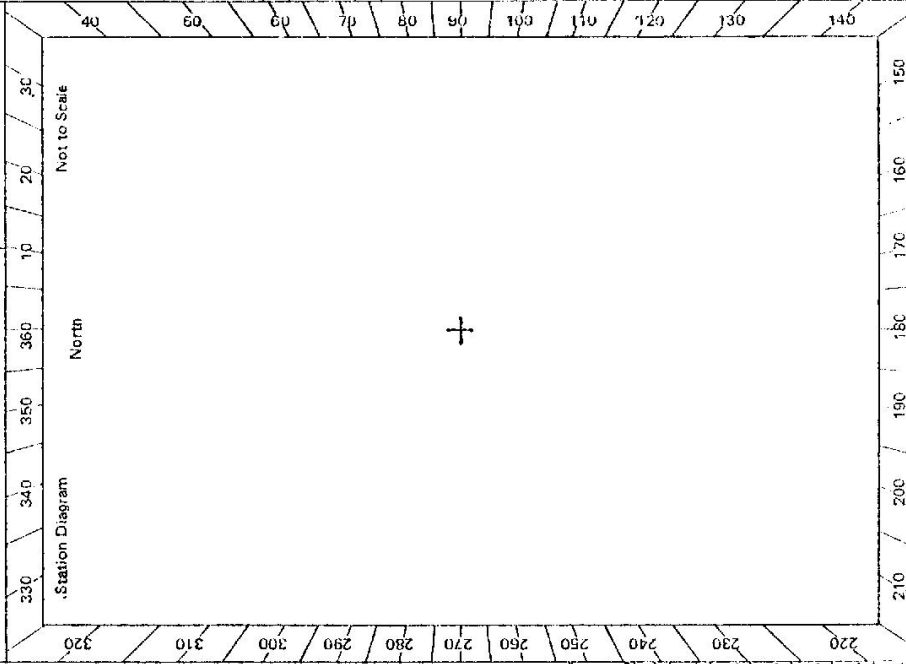

STANDPOINT:				STANDPOINT:			
Mark	Direction	Horiz. Distance	Height Difference	Mark	Direction	Horiz. Distance	Height Difference
			above standpt.				above standpt.
			below				below
			above standpt.				above standpt.
			below				below
			above standpt.				above standpt.
			below				below
			above standpt.				above standpt.
			below				below
			above standpt.				above standpt.
			below				below

Prepared by: *[Signature]*

Checked: *[Signature]*

Noted on U.T.M. Card

Checked

