CENTRAL MAPPING AUTHORITY — GEODETIC SURVEY OF N.S.W.

GEODETIC STATION RECONNAISSANCE and MAINTENANCE REPORT

STATION: BOLO	No.: 1040
MAP SHEET SCALE 1:250 000 CARGELLIGO	
INSPECTED BY: G.C. HANNA	DATE: 25/5/79
AUTHORITY: C.M.A.	FIELD BOOK:

Description: *Note: Cross out word or words which do not apply*

1. Cleared by lanes bearing..... from Trig. Mast
2. Mast & Vanes have been painted white & black respectively.
3. The station/pillar was unpiled/not unpiled/constructed on.....19....., dimensions now being:

   Description of mark.....should be explicit, e.g., S/Steel Pillar Plate, Steel plug, Brass plug, Bolt, G.I. Pipe

   Height of mark.....m. above/below rock/concrete; Mark is.....m. above/below G.L.

   Height of Top Vanes to Top Mark/Pillar plate .....m. Diameter of Vanes (vertical).....m.

   Height of Cairn.....m. Diameter of Cairn.....m. Name Plate found/not found/placed.

   Length of Mast .....m. (approximate if not unpiled)
4. A.....set in conc/rock has been placed/found, bearing.....°M from Mast/Plug/Pillar
5. A.....set in conc/rock has been placed/found, bearing.....°M from Mast/Plug/Pillar
6. A.....set in conc/rock has been placed/found, bearing.....°M from Mast/Plug/Pillar
7. A.....set in conc/rock has been placed/found, bearing.....°M from Mast/Plug/Pillar
8. Action required:.....

STANDPOINT: STANDPOINT:

Mark	Direction	Horiz. Distance	Height Difference	Mark	Direction	Horiz. Distance	Height Difference
			above/below standpt.				above/below standpt.
			above/below standpt.				above/below standpt.
			above/below standpt.				above/below standpt.
			above/below standpt.				above/below standpt.
			above/below standpt.				above/below standpt.
			above/below standpt.				above/below standpt.
			above/below standpt.				above/below standpt.

Station Diagram — North — Not to Scale

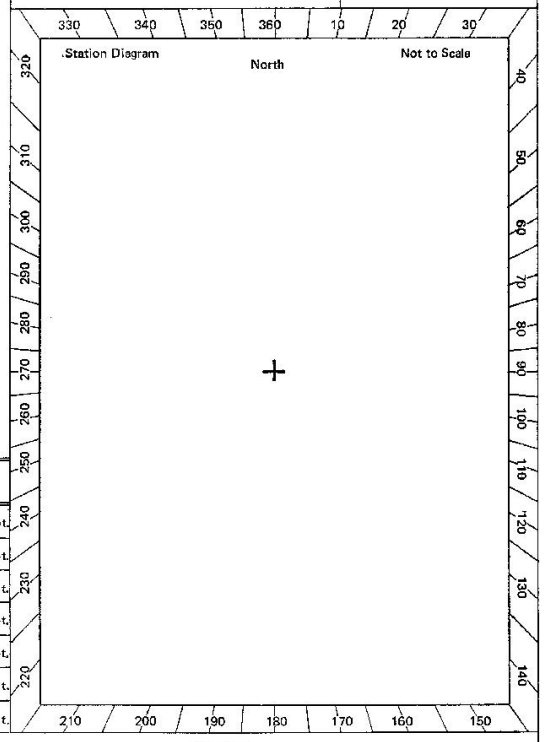

Prepared by: G.C. Hanna 28/5/79 *Checked:* *Noted on U.T.M. Card* *Checked*

St 2733–1

TS1040 | Print Date: 31/05/2022 15:16 | No Of Pages: 2 | Property of DFSI – Spatial Services

TS1040 | Print Date: 31/05/2022 15:16 | No Of Pages: 2 | Property of DFSI – Spatial Services

St 2733—2 D. West, Government Printer

STATION BOLO 1040

Beacon Diagram — Not to Scale

Owner's Name: .....

Address: .....

.....

Phone: .....

Current Occupant: .....

Address: .....

.....

Phone: .....

ACCESS

Access Report of 25/5/1979 was found suitable/unsuitable.

Rock cairn seen from N.E. M.S.V. not seen.

10 minute walk.

Light clearing.

See Kiacatoo 8231-N

This section to be completed by officer constructing pillar.

Original station mark found/not found.

Description of mark: .....

Original beacon found/not found.

Description of beacon: .....

Height Top of Vanes to Top Mark.....m.

Height of mark.....m. above/below rock/conc.....m. above/below G.L.

Diameter of Vanes .....m. Height of Cairn .....m.

Original Beacon has/has not been destroyed by me.

Date	Record of Station