Department of Lands

Integratio ;vey of N.S.W.

RECONNAISSANCE and MAINTENANCE REPORT

STATION TS 10608 CROSSLANDS

Co: CUMBERLAND | Ph: NORTH COLAH

Map Sheet: ARCADIA 1:10000 | No: UCC75-IX

Inspected by: MWS & D B. | Date: ——

Authority MWS & D B | Field Book: 412 KRE

This Trig. Station has been:-

Note: Cross out word or words which do not apply

1. Completely cleared to permit 360° vision to surrounding Trigs.
2. Cleared by lanes bearing..... from Trig. Mast
3. Trig. Mast & Vanes have been painted white & black respectively.
4. The Trig. was unpiled/not unpiled, dimensions now being: New Station

   Description of mark....Stainless Steel Pin..... should be explicit, e.g. Steel plug, Brass plug, Bolt, Concrete Pillar

   Height of mark.....m above/below rock/~~concrete~~ .....m above/below G.L.

   Height of To~~p Vanes to Top Mark/Top pillar plate~~ ..... m ~~Diameter of Vanes (vertical)~~ .....m.

   ~~Height of Cairn~~.....m. ~~Diameter of Cairn~~.....m.

   ~~Length of Mast~~.....m. ~~(approximate if not unpiled)~~
5. A Drill hole..set in ~~conc~~/rock has been placed/~~fd~~ 43.28 m. bearing.....°M/T from Trig. ~~Mast/pillar~~ Pin.
6. A.....set in conc/soil has been placed/fd .....m. bearing.....°M from Trig. Mast/pillar
7. A.....set in conc/soil has been placed/fd .....m. bearing.....°M from Trig. Mast/pillar
8. A.....set in conc/rock has been placed/fd .....m. bearing.....°M from Trig. Mast/pillar
9. Connection Clear in Tree to TS..... : 9.66 m. bearing 209 °M/T
10. Connection G.I Nail..to TS..... : 25.49 m. bearing 44½ °M/T
11. Connection.....to..... : ..... m. bearing.....°M
12. Connection.....to..... : ..... m. bearing.....°M
13. Diff. Ht. ..... is..... m. above/below .....
14. Diff. Ht. ..... is..... m. above/below .....
15. Diff. Ht. ..... is..... m. above/below .....
16. Diff. Ht. ..... is..... m. above/below .....

Beacon Diagram — Not to Scale

Stainless Steel Pin only

Date	Record of Station

Prepared by: [illegible] Checked: [illegible]

TS10608 | Print Date: 31/05/2022 18:38 | No Of Pages: 2 | Property of DFSI – Spatial Services

STATION TS 10608 CROSSLANDS

Station Diagram

Not to Scale

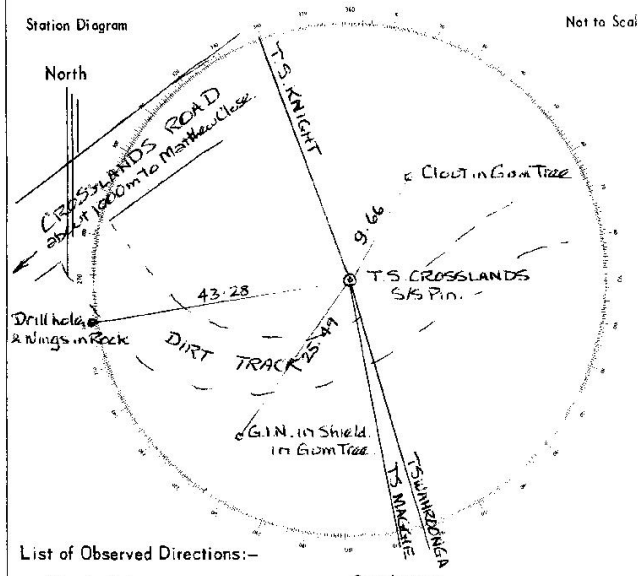

Owners Name CROWN LAND

Current Occupant

Address RECREATION RESERVE

Address

Access See UBD 16th Ed. Map 113 G9 and ARCADIA 1:10000 U0075

List of Observed Directions:–

Standpoint:

Station	Direction
TS KNIGHT	335°47'23.3
Clout	29°02'
TS WARROONGA	163°58'28.7
TS MAGGIE	169°50'18.8
G.I.Nail	224°36'

Standpoint:

Station	Direction
D.H. & Wings	259°58'

D. West, Government Printer, New South Wales — 1976

TS10608 | Print Date: 31/05/2022 18:38 | No Of Pages: 2 | Property of DFSI – Spatial Services