TS10703 | Print Date: 31/05/2022 18:40 | No Of Pages: 1 | Property of DFSI – Spatial Services

1: 25 000 LIVERPOOL 9030 - I -S

1: 10 000 LEPPINGTON U 8237

10703

STATION COW DE KNAVES (P)

ACCESS DIAGRAM

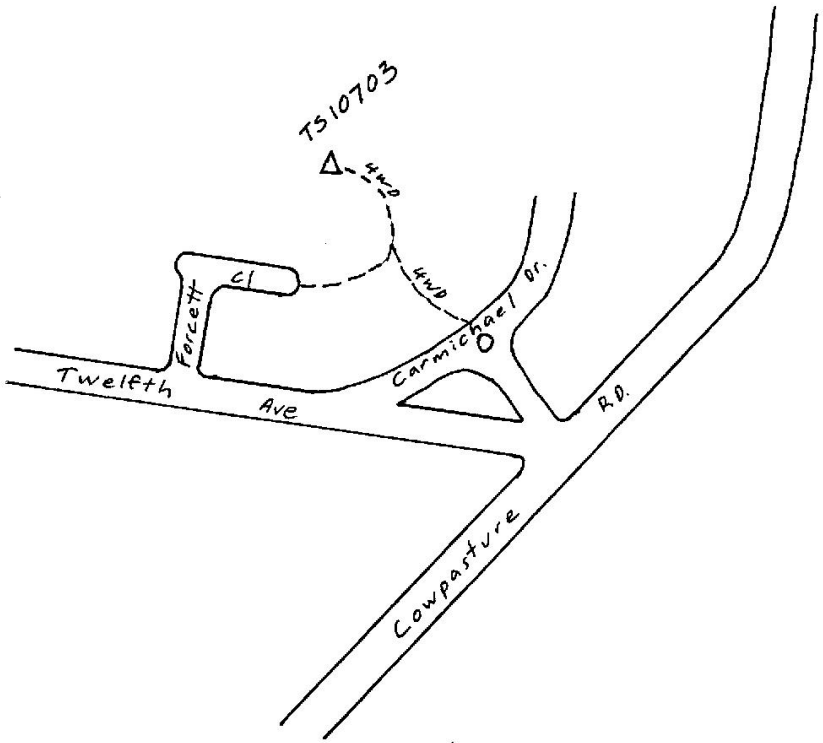

LAT 33° 55' 50" PROVISIONAL VALUES LONG 150° 50' 40"

AUSTRALIAN MAP GRID		INTEGRATED SURVEYS GRID	
METRES		METRES	
ZONE	C.M.	ZONE 561	C.M.
E	N	E	N
		285 420	1244180

Provisional Height 70 m(A.H.D); Agency: ISB

HISTORY OF STATION

Date	Record of Field Action Marking and Description of Station	Reference
16/5/80	Name assigned by G.N.B as COW DE KNAVES	1136