Department of Lands

Integratio rvey of N.S.W.

RECONNAISSANCE and MAINTENANCE REPORT

STATION TS 10780 (SERBIAN)

Co: CUMBERLAND | Ph: ST. LUKE

Map Sheet: FAIRFIELD 1/10000 | No: 9145

Inspected by: J. KWASNICA | Date: 1/2/83

Authority SURVEY CONTROL BR. | Field Book:

This Trig. Station has been:-

Note: Cross out word or words which do not apply

1. Completely cleared to permit 360° vision to surrounding Trigs.
2. Cleared by lanes bearing..... from Trig. Mast
3. Trig. Mast & Vanes have been painted white & black respectively.
4. The Trig. was unpiled/not unpiled, dimensions now being:

   Description of mark CHURCH CROSS should be explicit, e.g. Steel plug, Brass plug, Bolt, Concrete Pillar

   Height of mark.....m above/below rock/concrete .....m above/below G.L.

   Height of Top Vanes to Top Mark/Top pillar plate ..... m Diameter of Vanes (vertical).....m.

   Height of Cairn.....m. Diameter of Cairn ..... m.

   Length of Mast .....m. (approximate if not unpiled)
5. A.....set in conc/rock has been placed/fd .....m. bearing .....°M from Trig. Mast/pillar
6. A.....set in conc/soil has been placed/fd .....m. bearing.....°M from Trig. Mast/pillar
7. A.....set in conc/soil has been placed/fd .....m. bearing.....°M from Trig. Mast/pillar
8. A.....set in conc/rock has been placed/fd .....m. bearing.....°M from Trig. Mast/pillar
9. Connection.....to..... : ..... m. bearing.....°M
10. Connection.....to..... : ..... m. bearing.....°M
11. Connection.....to..... : ..... m. bearing.....°M
12. Connection.....to..... : ..... m. bearing.....°M
13. Diff. Ht. .....is.....m. above/below .....
14. Diff. Ht. .....is.....m. above/below .....
15. Diff. Ht. .....is.....m. above/below .....
16. Diff. Ht. .....is.....m. above/below .....

Prepared by: Julian Kwasnica Checked: [illegible]

Beacon Diagram — Not to Scale

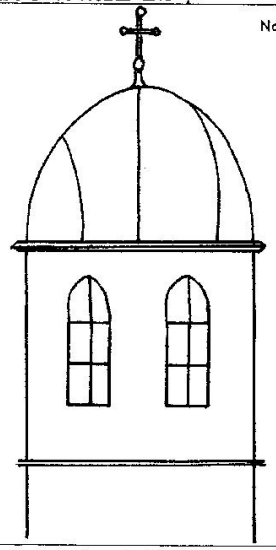

Date	Record of Station

TS10780 | Print Date: 31/05/2022 18:42 | No Of Pages: 2 | Property of DFSI – Spatial Services

STATION TS 10780 (SERBIAN)

Station Diagram

Not to Scale

North

INTERSECTION POINT ONLY

Owners Name SERBIAN CHURCH

Address CABRAMATTA RD

CABRAMATTA WEST

Current Occupant .....

Address .....

Access 1/2/1983

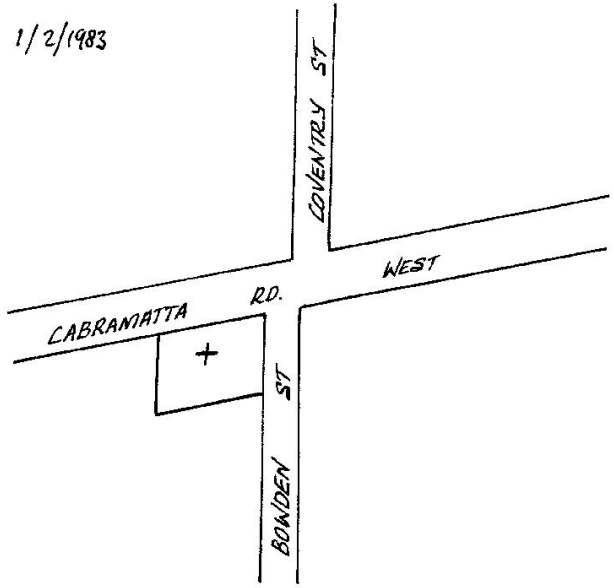

List of Observed Directions:–

Standpoint:

Station	Direction	Station	Direction

Standpoint:

Station	Direction	Station	Direction

D. West, Government Printer, New South Wales – 1976

TS10780 | Print Date: 31/05/2022 18:42 | No Of Pages: 2 | Property of DFSI – Spatial Services