Department of Lands

Integration Sur pf N.S.W.

RECONNAISSANCE and MAINTENANCE REPORT

T.S. 10806

STATION NARDI TV TWR

Co: ROUS | Ph: TERANIA

Map Sheet: TWEED HEADS | No: SH 56/3

Inspected by: C. WATKINS | Date: 28-10-51

Authority Telecom | Field Book: 1834

This Trig. Station has been:-

Note: Cross out word or words which do not apply

1. Completely cleared to permit 360° vision to surrounding Trigs.
2. Cleared by lanes bearing..... from Trig. Mast
3. Trig. Mast & Vanes have been painted white & black respectively.
4. The Trig. was unpiled/not unpiled, dimensions now being:

   Description of mark..... should be explicit, e.g. Steel plug, Brass plug, Bolt, Concrete Pillar

   Height of mark.....m above/below rock/concrete ..... m above/below G.L.

   Height of Top Vanes to Top Mark/Top pillar plate ..... m Diameter of Vanes (vertical)..... m.

   Height of Cairn.....m. Diameter of Cairn .... m.

   Length of Mast .....m. (approximate if not unpiled)
5. A.....set in conc/rock has been placed/fd .....m. bearing.....°M from Trig. Mast/pillar
6. A.....set in conc/soil has been placed/fd .....m. bearing.....°M from Trig. Mast/pillar
7. A.....set in conc/soil has been placed/fd .....m. bearing.....°M from Trig. Mast/pillar
8. A.....set in conc/rock has been placed/fd .....m. bearing.....°M from Trig. Mast/pillar
9. Connection.....to..... : ..... m. bearing.....°M
10. Connection.....to..... : ..... m. bearing.....°M
11. Connection.....to..... : ..... m. bearing.....°M
12. Connection.....to..... : ..... m. bearing.....°M
13. Diff. Ht. ..... is..... m. above/below .....
14. Diff. Ht. ..... is..... m. above/below .....
15. Diff. Ht. ..... is..... m. above/below .....
16. Diff. Ht. ..... is..... m. above/below .....

Beacon Diagram — Not to Scale

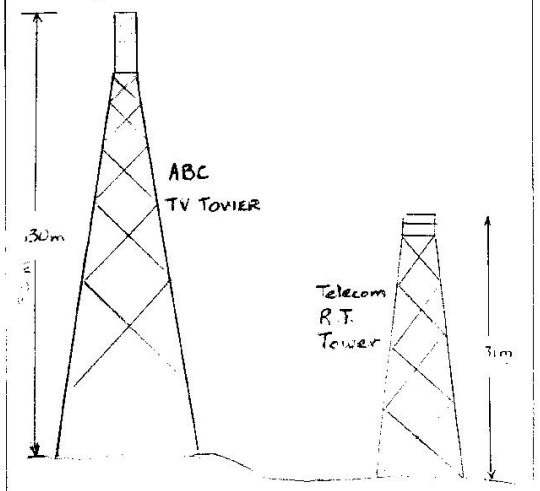

Date	Record of Station

Prepared by: C WATKINS Checked: [illegible]

TS10806 | Print Date: 31/05/2022 18:43 | No Of Pages: 2 | Property of DFSI – Spatial Services

T.S. 10806 STATION N RD1 T.V. TWR

Station Diagram — Not to Scale

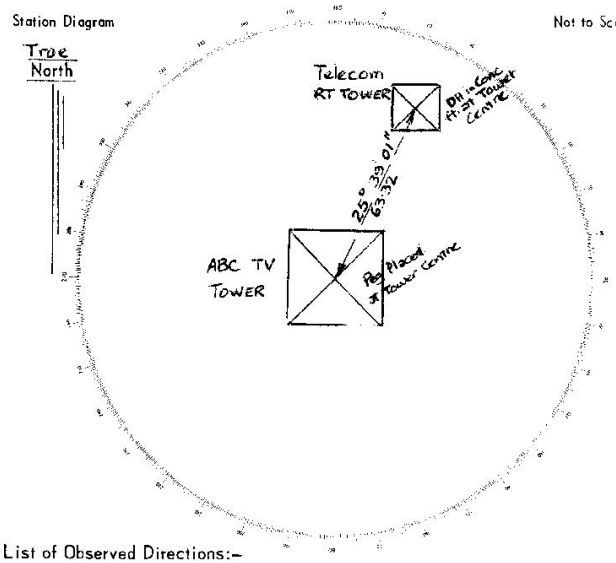

Owners Name A.B.C. ..... Current Occupant .....

Address ..... Address .....

~~Access~~ 28-10-1981 CO-ORDINATES COMPUTED FROM RESECTION & TELLUROMETER MEASUREMENT.

A. M. G.

ABC TV TOWER E 528031·3 N 6842140·9

Telecom RT TOWER E 528058·9 N 6842198·0

ZONE 56

List of Observed Directions:–

Standpoint: Standpoint:

Station	Direction	Station	Direction

Station	Direction	Station	Direction

TS10806 | Print Date: 31/05/2022 18:43 | No Of Pages: 2 | Property of DFSI – Spatial Services