CENTRAL MAPPING AUTHORITY

Department of Lands

Trigonometrical Survey of N.S.W.

RECONNAISSANCE and MAINTENANCE REPORT

74-98

STATION	BORAIG 1086
Co:	BUCCLEUGH
Ph:	BORAIG
Map Sheet:	YARRANGOBILLY
No:	8526-N
Inspected by:	G. C. HANNA
Date:	18/2/77
Authority	
Field Book:	

Beacon Diagram — Not to Scale

This Trig. Station has been:- *Note: Cross out word or words which do not apply*

1. Completely cleared to permit 360° vision to surrounding Trigs.
2. Cleared by lanes bearing ..... from Trig. Mast
3. Trig. Mast & Vanes have been painted white & black respectively.
4. The Trig. was unpiled/not unpiled, dimensions now being:

   Description of mark ..... should be explicit, e.g. Steel plug, Brass plug, Bolt, G.I. Pipe

   Height of mark ..... m above/below rock/concrete ..... m above/below G.L.

   Height of Top Vanes to Top Mark ..... m. Diameter of Vanes (vertical) ..... m.

   Height of Cairn ..... m. Diameter of Cairn ..... m.

   Length of Mast ..... m. (approximate if not unpiled)
5. A ..... set in conc/rock has been placed ..... m. bearing ..... °M from Trig. Mast
6. A ..... set in conc/soil has been placed ..... m. bearing ..... °M from Trig. Mast
7. A ..... set in conc/soil has been placed ..... m. bearing ..... °M from Trig. Mast
8. A ..... set in conc/rock has been placed ..... m. bearing ..... °M from Trig. Mast
9. Connection ..... to ..... : ..... m. bearing ..... °M
10. Connection ..... to ..... : ..... m. bearing ..... °M
11. Connection ..... to ..... : ..... m. bearing ..... °M
12. Connection ..... to ..... : ..... m. bearing ..... °M
13. Diff. Ht. ..... is ..... m. above/below .....
14. Diff. Ht. ..... is ..... m. above/below .....
15. Diff. Ht. ..... is ..... m. above/below .....
16. Diff. Ht. ..... is ..... m. above/below .....

NOT APPLICABLE

Date	Record of Station

Prepared by: Checked: Noted on U.T.M. Card Checked

TS1086 | Print Date: 31/05/2022 15:17 | No Of Pages: 2 | Property of DFSI – Spatial Services

STATION BORAIG. 1086

Station Diagram

Not to Scale

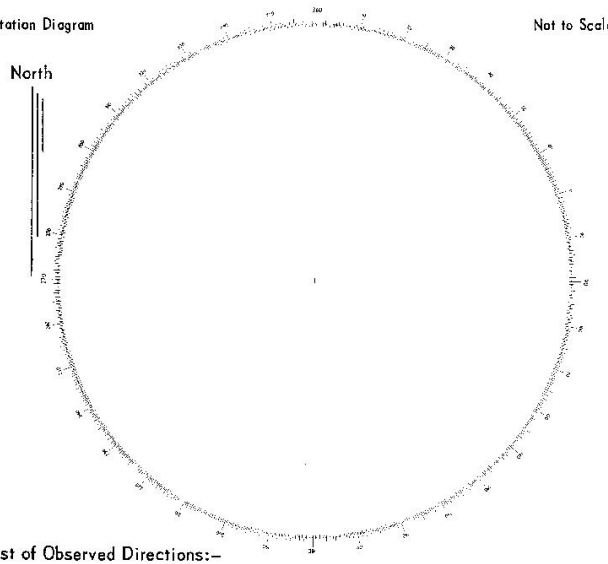

List of Observed Directions:–

Standpoint: Standpoint:

Station	Direction	Station	Direction

Station	Direction	Station	Direction

Owners Name.....

Address.....

.....

Current Occupant.....

Address.....

.....

Access 18-2-77

Diagram not to scale
Distances in Kilometres
Station mark not found

Access only - for additional information
See Yarrangobilly 1:25000 8526-1-S

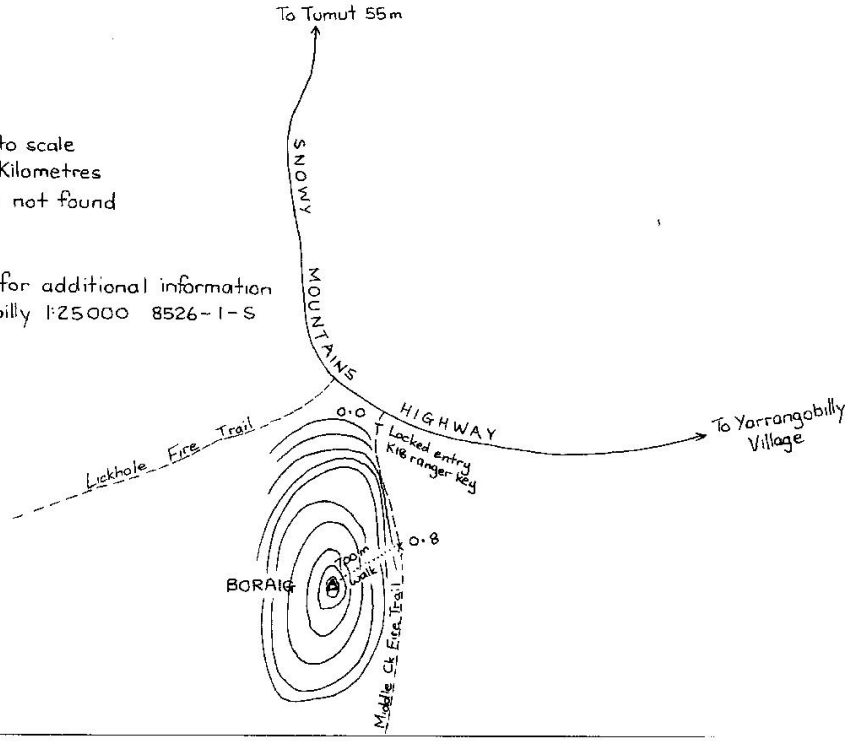

TS1086 | Print Date: 31/05/2022 15:17 | No Of Pages: 2 | Property of DFSI – Spatial Services