


7-10-10-3

Department of Lands Integratio urvey of N.S.W.
RECONNAISSANCE and MAINTENANCE REPORT

STATION **TERRANGOLA RES (P) IS 10900**
 Co: **ROUS** Pht: **Terrangola**
 Map Sheet: **TWEED HEADS** No: **4575-S**
 Inspected by: **A. DUFFY** Date: **27/10/89**
 Authority: **L. I. C.** Field Book:

Beacon Diagram Net to Scale

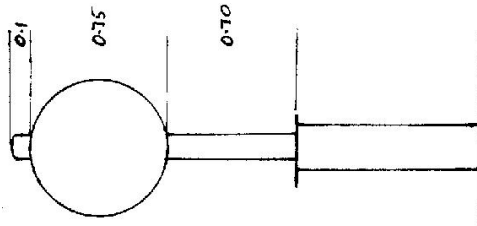

Date	Record of Station
14/6/89	Trig. Constructed
14/6/89	Trig. occupied

This Trig. Station has been:-
 Note: Cross out word or words which do not apply

1. Completely cleared to permit 360° vision to surrounding Trigs. ✓
2. Cleared by lanes bearing 360° from Trig. Mast
3. Trig. Mast & Vanes have been painted white & black respectively. ✓
4. The Trig. was unpiled/not unpiled, dimensions now being:
 Description of mark **Red top pillar plates** should be explicit, e.g. Steel plug, Brass plug, Bolt, Concrete Pillar
 Height of mark **0.75** m above rock/concrete **0.75** m above G.L.
 Height of Top Vanes to **Top Mark** Top pillar plate **1.45** m Diameter of Vanes (vertical) **0.75** m.



Prepared by: **A. Duffy** Checked: **A. Duffy**

