



STATION KATOOMBA (PT. S.)


Owners Name: Blue Mtns City Council

Current Occupant: .....

Address: .....

Address: .....

Access Conventional Vehicle  
 Note Key has to be obtained from Blue Mtns City Council.  
Access 100metres west of intersection of Fitzgerald St  
and Barton St + KATOOMBA

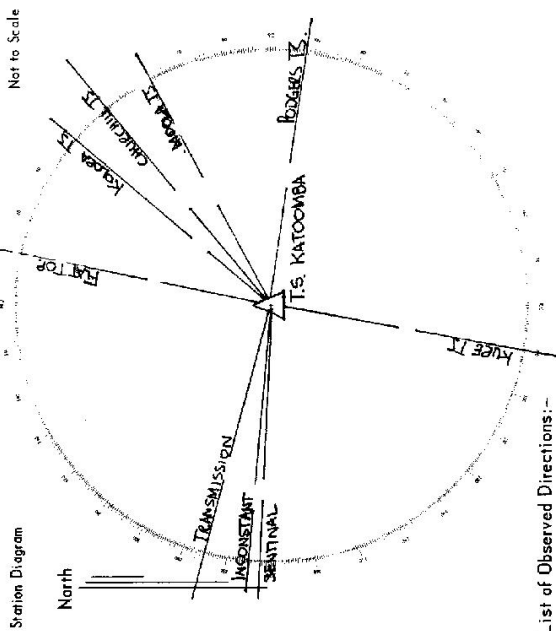

List of Observed Directions: -

Standpoint:		Station:		Direction:	
Station	Direction	Station	Direction	Station	Direction
Standpoint:		Station:		Direction:	
Station	Direction	Station	Direction	Station	Direction