TS10954 | Print Date: 31/05/2022 18:47 | No Of Pages: 2 | Property of DFSI – Spatial Services

DEPARTMENT OF LANDS

TS 10954

STATION SMA 1271

Map Name KHANCOBAN Scale 1: 50,000
Map Number 8525-N Portion 3 and 4
County SELWYN Parish YOUNGAL
Aerial Photographs
Plan Reference

Station Diagram — Not to Scale

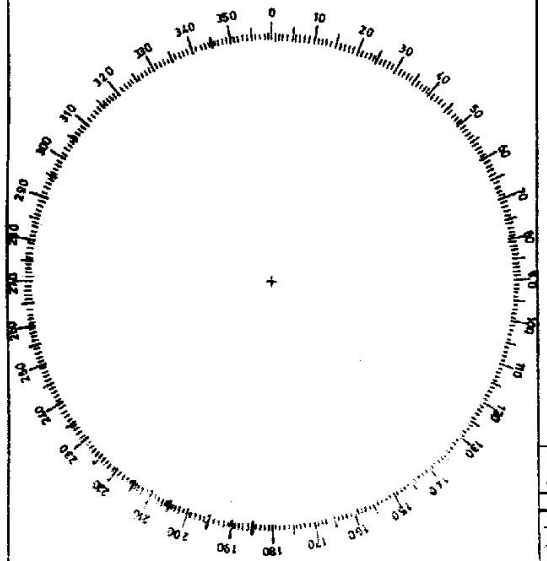

Unit of Measurement: Metre (1 Metre = 3.281 ft approx)
Diff. Ht (minus PM/SSM)

Verified Date
Certified Date Amended

Original Station Established by — Date — Order

DATUM: Australian Geodetic Datum 1966 a= 6,378,160 metres; 1/f = 298.25; Johnston Origin
RECTANGULAR CO-ORDINATES: Australian Map Grid in Metres
Adjustment No: H V
Grid Bearing = Adj. Azimuth + Convergence HEIGHT: A.H.D. in metres Trig Lev

SOUTH LATITUDE	EAST LONGITUDE	ZONE	EASTING	NORTHING	CONVERGENCE
		553	223600	989100	

TO	ADJ AZIMUTH	ADJ LENGTH

Field Book — Description Book
Abstract Book — Bearing or Triangulation Book

Date	Marks and Description of Station	Reference
	Station Mark	
	Beacon	
	Effective Height	

Station last visited (Year)

Date Amended Date Amended Date Amended Date

TS 10954

STATION SMA 1271

ACCESS DIAGRAM

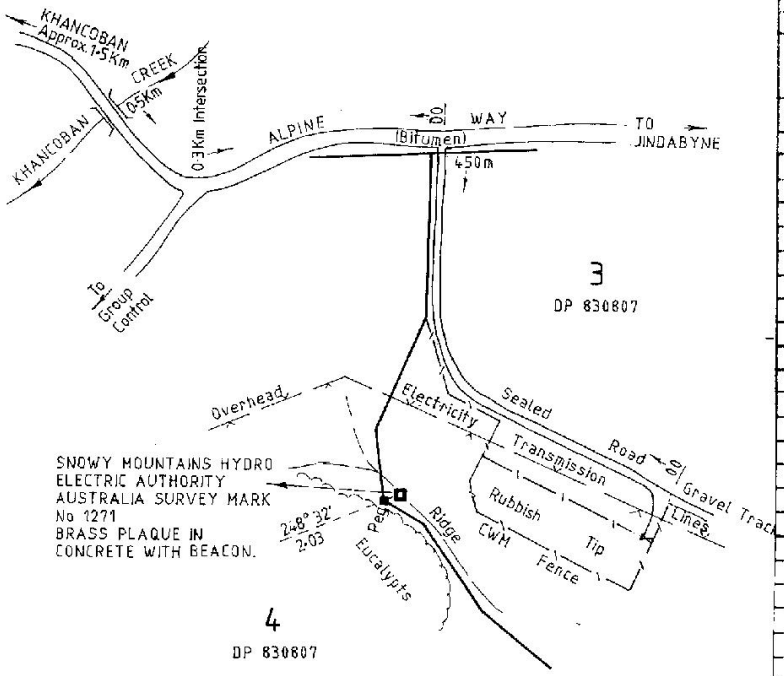

PROVISIONAL VALUES

AUSTRALIAN MAP GRID METRES			INTEGRATED SURVEYS GRID METRES		
ZONE	C.M.		ZONE	C.M.	
	E	N		E	N

Provisional Height ..... m (A.H.D); Agency: .....

HISTORY OF STATION

Date	Record of Field Action Marking and Description of Station	Reference

TS10954 | Print Date: 31/05/2022 18:47 | No Of Pages: 2 | Property of DFSI – Spatial Services