TS130

TS130 CMA 1-063
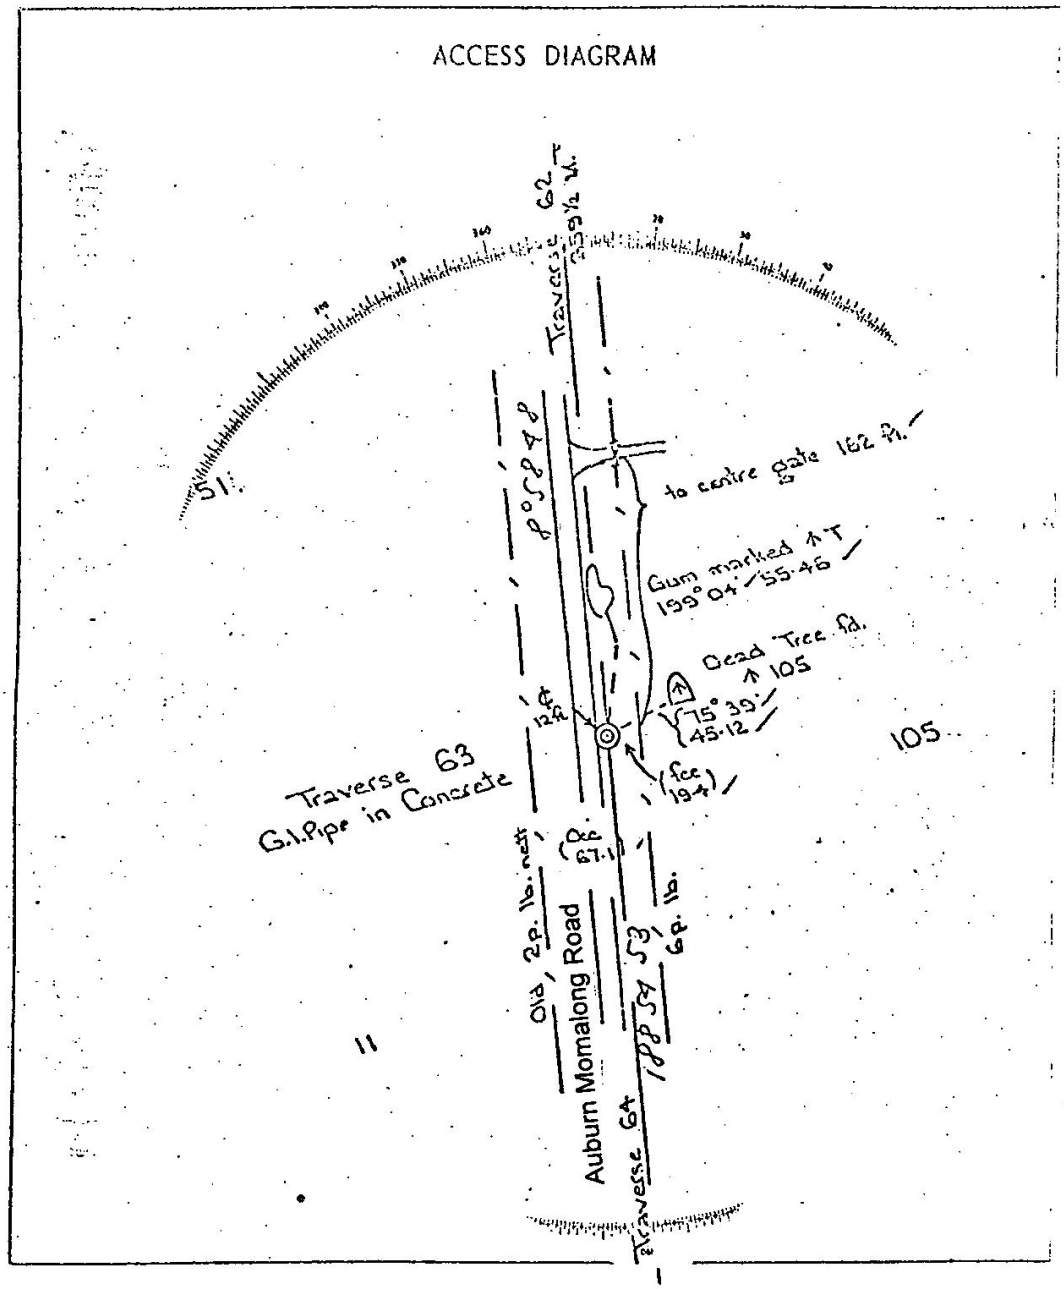
Location : **Savernake**
LGA : **Berrigan**