CENTRAL MAPPING AUTHORITY

GEODETIC SURVEY OF N.S.W.

GEODETIC STATION RECONNAISSANCE and MAINTENANCE REPORT

STATION: BYWONG No.: 1335

MAP SHEET SCALE 1:250 000: CANBERRA SUTTON 1:25000

INSPECTED BY: W.E. Sainsbury DATE: Sept. 1978

AUTHORITY: Dept of Main Roads FIELD BOOK:

Description: *Note: Cross out word or words which do not apply*

1. Cleared ~~by lanes bearing~~.....in...mast.....directions.....from Trig. Mast
2. ~~Mast & Vanes have been painted white & black respectively.~~
3. ~~The station/pillar was unpiled/not unpiled/constructed on.....19.....dimensions now being~~:

Description of mark. Brass plug in conc should be explicit, e.g., S/Steel Pillar Plate, Steel plug, Brass plug, Bolt, G.I. Pipe

Height of mark.....m. above/below rock/concrete; Mark is.....m. above/below G.L.

Height of Top Vanes to Top Mark/~~Pillar plate~~ ..5.12.....m. approx. Diameter of Vanes (vertical)..0.91.....m.

~~Height of Cairn~~.....m. ~~Diameter of Cairn.....m.~~ Name Plate found/not found/placed.

Quadripod over mark.

~~Length of Mast~~ .....m. (approximate if not unpiled)

4. A.....set in conc/rock has been placed/found, bearing.....°M from Mast/Plug/Pillar
5. A.....set in conc/rock has been placed/found, bearing.....°M from Mast/Plug/Pillar
6. A.....set in conc/rock has been placed/found, bearing.....°M from Mast/Plug/Pillar
7. A.....set in conc/rock has been placed/found, bearing.....°M from Mast/Plug/Pillar
8. Action required:.....Nil.....

STANDPOINT:

Mark	Direction	Horiz. Distance	Height Difference
			above/below standpt.
			above/below standpt.
			above/below standpt.
			above/below standpt.
			above/below standpt.
			above/below standpt.
			above/below standpt.

STANDPOINT:

Mark	Direction	Horiz. Distance	Height Difference
			above/below standpt.
			above/below standpt.
			above/below standpt.
			above/below standpt.
			above/below standpt.
			above/below standpt.
			above/below standpt.

Station Diagram — North — Not to Scale

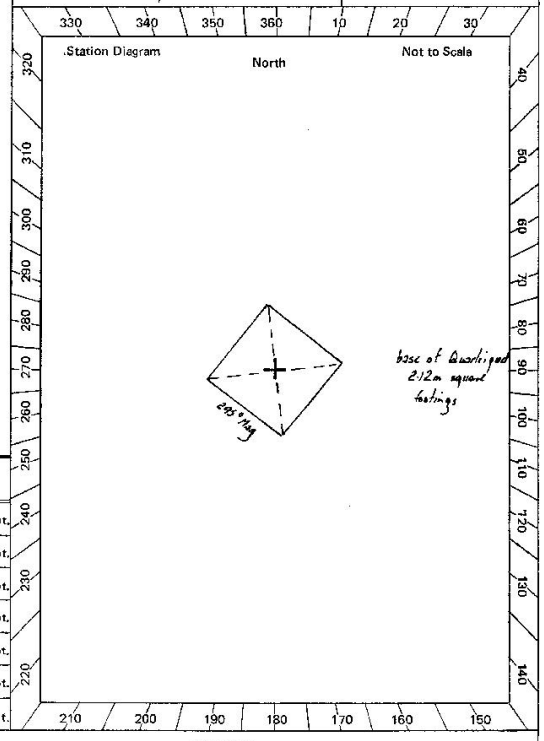

Prepared by: W.E. Sainsbury *Checked:* *Noted on U.T.M. Card* *Checked*

St 2733–1

TS1335 | Print Date: 31/05/2022 15:23 | No Of Pages: 2 | Property of DFSI – Spatial Services

St 2733—2 D. West, Government Pri...

STATION BYWO. 5 TS 1335

Beacon Diagram — Not to Scale

Owner's Name: A.J. (Tal.) Wicks

Address: Business Sports Store in Queanbeyan

Home 13 Kihard St Queanbeyan

Phone:

Current Occupant:

Address:

Phone:

ACCESS

Access Report of 1990 was found ~~suitable~~/unsuitable.

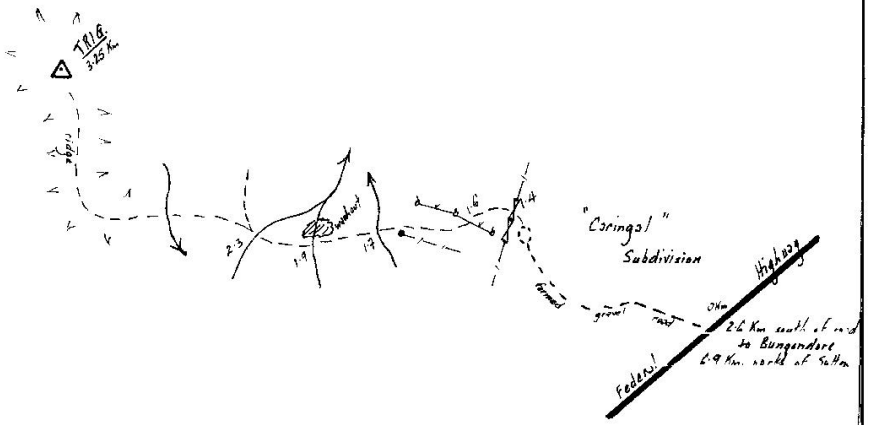

This section to be completed by officer constructing pillar.

Original station mark found/~~not found~~.

Description of mark: See over

Original beacon found/~~not found~~.

Description of beacon: Non Quadrigonal

Height Top of Vanes to Top Mark 5.12 m. approx.

Height of mark ..... m. above/below rock/conc ..... m. above/below G.L.

Diameter of Vanes 0.91 m. ~~Height of Cairn~~ ..... m.

Original Beacon has/~~has not~~ been destroyed ~~by me~~.

Date	Record of Station

TS1335 | Print Date: 31/05/2022 15:23 | No Of Pages: 2 | Property of DFSI – Spatial Services