CENTRAL MAPPING AUTHORITY

Department of Lands

Trigonometrical Survey of N.S.W.

RECONNAISSANCE and MAINTENANCE REPORT

74-98

STATION CASTLEROCK / TS - 1434

Co:	Ph:
Map Sheet: MUSWELLBROOK	No: 9033 N
Inspected by: P CHEN /	Date: 25-4-77
Authority C.M.A. ✓	Field Book: 1565 /

Beacon Diagram — Not to Scale

This Trig. Station has been:- *Note: Cross out word or words which do not apply*

1. Completely cleared to permit 360° vision to surrounding Trigs.
2. ~~Cleared by lanes bea~~ring ..... from Trig. Mast
3. ~~Trig. Mast & Vanes have been painted white & black respective~~ly.
4. The Trig. was unpiled/not unpiled, dimensions now being: Original Station Mark ~~found~~/not found

   Description of mark ..... — ..... should be explicit, e.g. Steel plug, Brass plug, Bolt, G.I. Pipe

   Height of mark ..... — ..... m above/below rock/concrete ..... — ..... m above/below G.L.

   Height of Top Vanes to Top Mark ..... — ..... m. Diameter of Vanes (vertical) ..... — ..... m.

   Height of Cairn ..... — ..... m. Diameter of Cairn ..... — ..... m.

   Length of Mast ..... 7.6 ..... m. (approximate if not unpiled)
5. A ..... set in conc/rock has been placed ..... m. bearing ..... °M from Trig. Mast
6. A ..... set in conc/soil has been placed ..... m. bearing ..... °M from Trig. Mast
7. A ..... set in conc/soil has been placed ..... m. bearing ..... °M from Trig. Mast
8. A ..... set in conc/rock has been placed ..... m. bearing ..... °M from Trig. Mast
9. Connection ..... to ..... : ..... m. bearing ..... °M
10. Connection ..... to ..... : ..... m. bearing ..... °M
11. Connection ..... to ..... : ..... m. bearing ..... °M
12. Connection ..... to ..... : ..... m. bearing ..... °M
13. Diff. Ht. ..... is ..... m. above/below .....
14. Diff. Ht. ..... is ..... m. above/below .....
15. Diff. Ht. ..... is ..... m. above/below .....
16. Diff. Ht. ..... is ..... m. above/below .....

Date	Record of Station

Prepared by: P CHEN Checked: Noted on U.T.M. Card Checked

TS1434 | Print Date: 31/05/2022 15:25 | No Of Pages: 2 | Property of DFSI – Spatial Services

STATION CASTLEROCK TS- 1434

Station Diagram — Not to Scale

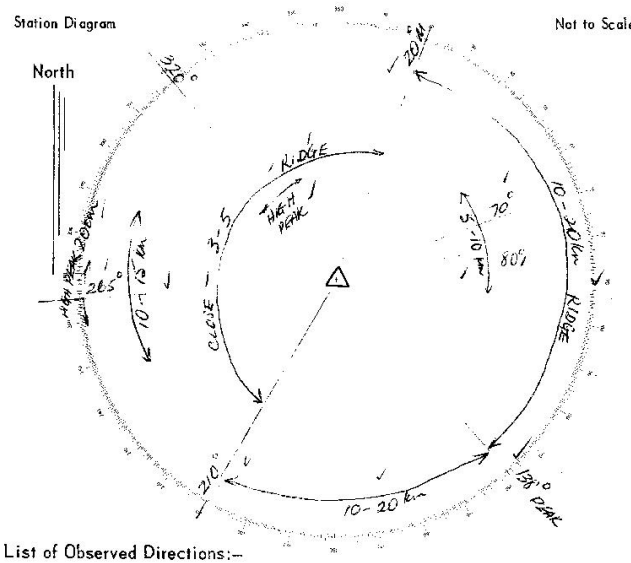

Owners Name P. KEAST

Address "CASTLE ROCK"

MILSWELLBROOK

Current Occupant

Address

Access 25-4-1971

Km	FEATURES
0.0	MILSWELLBROOK P.O. TAKE NEW ENGLAND HWY TOWARDS TAMWORTH
1.2	PASS RIGHT ON RIGHT. GO ST. AHEAD.
1.5	T-INTER^N. TAKE ROAD TO SANDY HOLLOW ON RIGHT.
2.0	T-INTER^N ~~TAKE~~ TURN RIGHT, TAKE ROAD TO 'KAYUGA' & CROSS BRIDGE
2.9	T-INTER^N GO ST. AHEAD.
3.3	PASS ROAD ON LEFT. GO ST. AHEAD.
6.2	T-INTER^N. TURN RIGHT, TAKE 'CASTLE ROCK' ROAD.
16.8	END OF BITUMEN
17.8	CROSS FORD
18.9	PARK VEHICLE AT TOP OF THE CREST. CASTLE ROCK TRIG ON LEFT

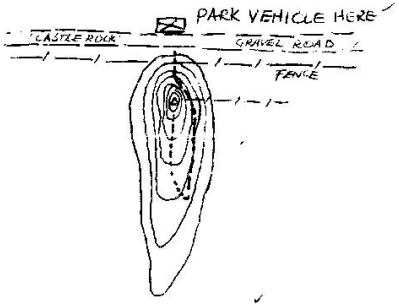

OVER THE FENCE AND WALK TOWARDS THE EASTERN THE ROCK. FOLLOW WALKING TRACK AND KEEP TO THE LEFT [illegible] THE ROCK ON EASTERN SIDE & TOWARDS THE SOUTHERN END. CROSS THE FENCE [illegible] THEN MAKE YOUR OWN WAY TO THE TOP. GOOD LUCK.

List of Observed Directions:–

Standpoint:

Station	Direction	Station	Direction

Standpoint:

Station	Direction	Station	Direction

* OWNER'S HOUSE ABOUT 0.7 KM DOWN THE ROAD WESTWARD

TS1434 | Print Date: 31/05/2022 15:25 | No Of Pages: 2 | Property of DFSI – Spatial Services