
Department of Lands			
	RECONNAISSANCE and MAINTENANCE REPORT	STATION LOUNABARAGRAN	TS-1615
This Trig. Station has been:-	Note: Cross out word or words which do not apply	Co: GOWEN Ph: LUCIVI	Ph: LUCINARAMABRIAN
1. Completely cleared to permit 360° vision to surrounding Trigs	urrounding Trigs.		Date: FLORLARY 1777
2. Cleared by lanes bearing	from Trig. Mast	Authority	Field Book:
3. Trig. Mast & Vanes have been painted white & black respectively.	& black respectively.	Beacon Diagram	Not to Scale
4. The Trig. was unpiled/potruppiled, dimensions now being:	ıs now being:		
Description of markNAG	Description of mark <i>NAUSt.N.CR.eVS.RR.T.C.</i> should be explicit, e.g. Steel plug, Brass plug, Bult, G.I. Pipe		
Height of mark	rock/concrete m ^{above} G.L.		
Height of Top Vanes to Top Mark m.	. Diameter of Vanes (vertical)m.	No UNEN CU BUNCON	
Height of Cairn,	Diameter of Cairn		
Length of Mast	(approximate if not unpiled)		
5. Aset in conc/rock has been placed	edm. bearing		
6. Aset in conc/soil has been placed	eda. bearing		
7. Aset in conc/soil has been placed	edm. bearing		
8. A	edm. bearing		
9. Connectiontoto	m. bearing		
10. Connectiontototo	n. bearing		
11. Connection to to	:	Date Record of Station	
12. Connectiontoto	n. bearing		
13. Diff. Ht	avaia		
la, Diff. Hi.	m. dhëve below		
15. Diff. Ht.	n, above		
16. Diff. Ht. /	alove below		
Prepared by: 11114 to \$3/3/77 Checked:	Noted an U.T.M. Card	Checked	

 $-\infty$

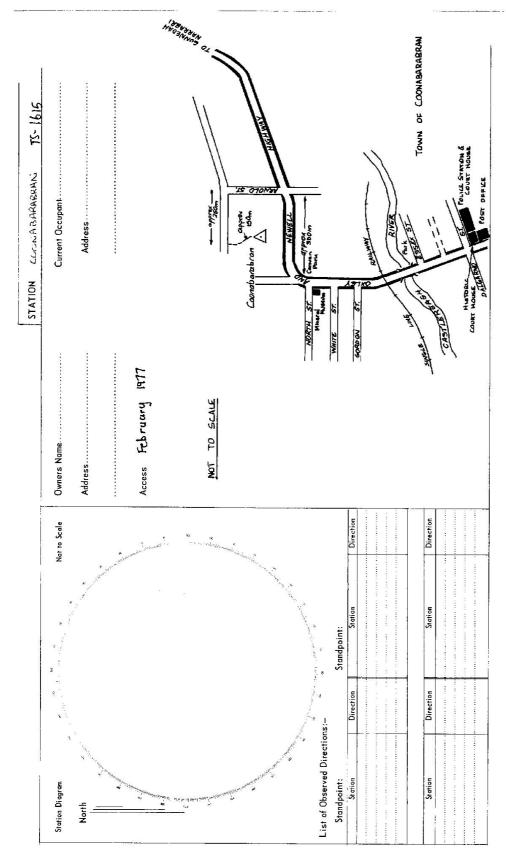

Department of Lands	RECONNAISSANCE and MAINTENANCE REPORT	STATION COONABARABAN GS. TS. 1615
This Trig. Station has been:-	Nate: Crass out word or words which do not apply	Co: Gover Ph: Coursesand
		BRAN
 Completely cleared to permit 360° vision to surrounding trigs. 	n to surrounding Tr igs.	Inspected by: P MY/DP Date: 17 Hattarf, 1977
2. Cleared by lanes bearing	from Trig. Mast	Authority CENTRAL MADPARIE ANTHORITY Field Book: AB 1559
3. T rig. Mast & Vanes -h ave bes n-painted white & black respectively.	vhite & black respective ly.	Beacon Diagram
4. Th e Trig. was unpiled/not unpiled, dimensions now bein g:	ansions now being:	
Description of mark. Steet P.M. 14, 201. Ft	Description of mark. Steel Poil 14, 2001, Dord Law (Nack WEll should be explicit, e.g. Steel plug, Brass plug, Bolt, G.I. Pipe	No BEALON FD.
Height of markn	m above rack/concrete	
Height of Top Vanes to Top Markm.	Diameter of Vanes (vertical)m.	
Height of Cairn	Diameter of Centra /. <i>Q</i> m.	
Length of Mast	vroximate if not unpiled)	
5. A	n placedm. bearinga.M from Trig. Mast	
6. Aset in conc/soil has been placedn.bearing	n placed	
7. Aset in conc/soil has been ploced	n placedm. bearing	REMARKS .
8. Aset in conc/rock bas been placed	n placedm. bearing	EXTENSIVE CLEMING REQUIRED.
	N ^a critical	LANES CLEARED TO NANDI OF & LOWN SI LUNNENNING
COLUMN COLUMN		SUITABLE FOR CONS PILIAR.
10. Connectionto	m. bearing	
11. Connection	m bedring	Date Record of Station
12. Connectiontoto.		
13. Diff. Htis	ababa below	
14. Diff. Ht.	m, dhove	
15. Diff. Ht.	m, obsve	
Diff. Ht.	below Ubyre M. ubyre	
Prenned hus P (16)	Charked A. Curd Noted on U.T.M. Curd	Checked A. Checked A. Checked

_ - - -

	Owners Name	Address	17-8-1977	-ARECTIONS	COMMANNAM POST OFFICE, THE GUINNEDAH RD DVER LASTEREIGH RIVER	GERNEL RD. TURN LEFT.	FENCE CROSSES RD. TURN LEFT AT FENCE. FOLLOW TOAL ALONG POWER LINE.	TUBN LETT ALONG TRACK TO TRIG.	7120 6.					
-	Not to Scale Owners Nar	Address	Access		5. 0.0	/3	, <i>is</i>	11	81		Direction	 	Direction	
	Station Diagram	North	a lange and a l	Normal Providence State	i-14ettr-18th	nte costitución	efficients and	Constraint of	List of Observed Directions:-	Standpoint:	Station		Station	

2		GEODETIC ST	TATION RE	GEODETIC STATION RECONNAISSANCE and MAINTENANCE REPORT	ENIAM MAINT	TENANCE R	EPORT	STATION: C	STATION: CONNABARABILAN CS	L CS	No.: 1615
Description:			Note:	Note: Cross out word or words which do not apply	r words whic	h do not app	Ŋ	MAP SHEET SCALE 1:250 0	MAP SHEET SCALE 1:250 000 CIL CAN DRA	JRA.	
Cleared by lanes	bearing	Geared by lanes bearing	I MUSEIKE			n Trig-Mast		INSPECTED BY	INSPECTED BY: L HITCHINS	DATE:	DATE: 3.7 Si
2. Mast & Vanes ha	wa baan paintad .	Mast & Vanes have been painted white & black respectively.	pectively .					AUTHORITY:	D M D	FIELD	FIELD BOOK: 153 C
3. The station/pilla	r was unpited/no	t-unpiled/constru-	cted on	The station/pillar was unpiled/not unpiled/constructed on momentum 19 dimensions now being:	, dimonsi	ons now boir	:6	330	340 350 360	1 10 / 20) 30/
Description of m	arkQuere	ر ۱should be expl	licit, e.g., S/	Description of markSitE.tShould be explicit, e.g., S/Steel Pillar Plate, Steel plug, Brass plug, Bolt, G.I. Pipe	Steel plug, Br	ass plug, Bol	t, G.I. Pipe	Station Diagram		Ň	Not to Scale
Height of mark	AT	Height of markAtAtAt.		Mark is	· below G.L.			.,			
Height of Top V	anes to Top Mark	Height of Top Vanes to Top Mark/Pillar platenn.	μ.		Diameter of Vanes (vertical)m.	(vertical)			POSSIBLE & SEE FORK CS	E FORK CS	interver.
Height of Cairn	Height of Cairn		ster of Cai rn	-Diameter of Gairn		found/not fe	und/placed.	The second second	POSSIBLE to SEE NANDI CS.	EE NANDI	CS-
Length of Mast			(approximate if not unpiled)	piled)				NET	NEEDS CLEARING	١٢.	
4. A		onc/rock has been	n placed/fou	set in conc/rock has been placed/found, bearing	°M from	Mast/Plug/Pii	lar		2Y Lenu H	الدر	
5. A.	set in c	onc/rock has been	n placed/fou	A	°M from I	Mast/Plug/Pi	lar	SIATI	1	APPRex 5	M:205
 A	set in c	onc/rock has been	uplaced/fou	nd, bearing	^o M from I	Mast/Plug/Pil	lar	-28 HOLY	PROM HICHLESS	PART OF HILL	1 1
7. A	set in co	onc/rock has been	n placed/fou	nd, bearing	°M from I	Mast/Plug/Pi	lar	0ZZ	+		
8. Action required:	CONTRACT. DEDT OF	LANDS, RE LENS	SEE. No.	Action required: (_eNIRCL_DEDT_OF_LARSEENoEx., CHARCSEX., CHARCSEX., ACTION_	TUNO.			560			
STANDPOINT:				STANDPOINT:				\ D'			
Mark	Direction	Horiz. Distance	ference	Mark	Direction	n Distance	Height Difference	39			
		abov	above standpt. below				above standpt,	540			
		abov belov	above standpt. below				below standpt.				
		above show s	above standpt.				below standpt	530			
		abor	above standpt. below				above standpt.				
		abor	above standpt.				above standpt,				
		abor belor	above standpt. below				above standpt. N	555			
		abov	above standpt.				above standpt. below	210 /	200 1 190 180	1/10/1	150
	11 000			As 1 01 1							











































































































































































































































































































 | Image: Station Station

 | Image: Station Norto Sele Owner's Name:

 | Image: Station Norto Sele Owner's Name:

 | Image: Construction of the Serie of the Serie of Management Notice Serie of the























































































































































































































 | Norto Scale Norto Scale Owners Name: Carlon Land Address: D.D.D.C.C. Phone: D.D.C.C. Phone: D.C.C.C. Address: D.C.C.C. Phone:

 | Notio Seale Notio Seale Ownars Name:

 | Notio Scale Notio Scale Notio Scale Ownar's Name:

 | Not to Seele Not to Seele Owner's Name: Kich, M.

 | Morto Seele Owner's Name:
 | Nor to Seale Owner's Name:

 | Nor to Seale Owner's Name:

 | Nor to Seale Owner's Name:
 | Nor to Seale Owner's Name:
 | Not to Seele Owner's Name:

 | Not to Seele Owner's Name:
 | NOT DE SERIE
OWNER'S NAME:
 | NOT DE SERIE OWNER'S NAME:
 | Norroscele Owners Name: Manh
 | Norrossie Owners Name: March, Manh. Address: March,
 | Not to Scale Owners Name: Richards, Rahd. Address: Darber, MEAN, Mand. Address: Darber, Mand. | Not to Scale Owners Name: Richards, Rahd. Address: Darber, MEAN, Mand. Address: Darber, Mand. | Norrossie Owners Name: March, Manh. Address: March,
 | Norrossie Owners Name: March, Manh. Address: March, | Norrossie Owners Name: March, Manh. Address: March, |
| 1-75 tuch
1-75 tuch | Not to Seele Ownar's Name:

 | Not to Seale Not to Seale Ownar's Name: C. R.C.M.M. (ANNA

 | Image: Station Image: Station

 | Image: Station Image: Station

 | Nor to Seele Nor to Seele Owner's Name: Kichursh. (ASNA)

 | Image: Station Image: Station

 | Image: Station Image: Station

 | Norto Seale Norto Seale Norto Seale Owners Name:

 | Not to Seale Not to Seale Ownar's Name: C. R.C.M.M. (ANNA

 | Notio Scale Notio Scale Notio Scale Ownar's Name:
 | Not to Seele Not to Seele Owner's Name: Chickin, LANIA

 | Nor to Seele Owner's Name:

 | Nor to Seele Owner's Name:
 | Nor to Seele Owner's Name:

 | Nor to Seele Owner's Name:
 | Not to Scale Owner's Name:
 | Not to Scale Owner's Name:

 | NO REACTOR Scale Conner's Name:
 | Nor to Scale Owner's Name: March, MANA | Nor to Scale Owner's Name: March, MANA
 | Nor to Scale Owner's Name: Michaelian (Recursts | Nor to Scale Owner's Name: Michaelian (Recursts | Nor to Scale Owner's Name: Michaelian (Recursts
 |
| La Sach | Norto Seele Norto Seele Owner's Name: MANA

 | Not to Seele Not to Seele Owner's Name:

 | Image: Station Not to Seale Ownar's Name:

 | Image: Station Not to Seale Ownar's Name:

 | Image: Station Image: Station

 | Image: Station Not to Seale Ownar's Name:

 | Image: Station Not to Seale Ownar's Name:

 | Image: State of the state o
 | Not to Seele Not to Seele Owner's Name:

 | Nor to Seale Owner's Name:
 | Norto Seele Owner's Name: Kachtha, KANA Norto Seele Owner's Name: MAAA

 | Nor to Seele Owner's Name: K.C.W.M
 | Not to Serie Owner's Name: K.C.M.M

 | Not to Serie Owner's Name: K.C.M.M
 | Not to Serie Owner's Name: K.C.M.M

 | Not to Serie Owner's Name: K.C.M.M
 | Not to Seele Owner's Name:

 | Not to Seele Owner's Name:
 | Not to Scale Owner's Name:
 | Nor to Seele Owner's Name: | Nor to Seele Owner's Name:
 | North Seele North Seele North Seele Owner's Name: Address: D.C.G.C. Phone: D.C.G.C. Access Report of Amale Network at its between desited between the state of a
 | Not to Scale Not to Scale Not to Scale Owner's Name: Address: Dialogic
| | Not to Scale Owner's Name:

 | Not to Scale Not to Scale Not to Scale More serie Ownar's Name:

 | Norto Scale Norto Scale Connars Name:

 | Norto Scale Norto Scale Connars Name:


 | Norto Scale Norto Scale Connars Name:

 | Norto Scale Norto Scale Connars Name:

 | Not to Seale Not to Seale Connar's Name:
 | Not to Scale Not to Scale Not to Scale More serie Ownar's Name:

 | Not to Seele Not to Seele Owner's Name: Kich, M. K. ANNA Address: Dir. R. L. R. M. K. M.
 | Nor to Scale Owner's Name:

 | Nor to Seele Owner's Name:

 | Nor to Seale Owner's Name:
 | Nor to Seale Owner's Name:

 | Nor to Seale Owner's Name:
 | Nor to Seale Owner's Name:

 | Nor to Seele Owner's Name:
 | Nor to Seele Owner's Name:
 | Not to Scale Owner's Name:
 | Nor to Scale Owner's Name:
 | Nor to Seele Owner's Name: | North Scale North Scale North North Scale North North

 | Not to Scale Not to Scale Not to Scale Owner's Name: Address: D.O.O.A. No P | Norrossie Owners Name: Chr.L.M. (ANN)
 | Not to Scale Owners Name: Klouch M. LAND Address: | Not to Scale Owners Name: Klouch M. LAND Address:
 | Norrossie Owners Name: Chr.L.M. (ANN) | Norrossie Owners Name: Chr.L.M. (ANN) | Norrossie Owners Name: Chr.L.M. (ANN)
 |

 | Norto Scale Norto Scale Norto Scale Ownars Name: Comars Name: Carlon Address: Dane: Dane: Address: Dane: Address:

 | Image: Station Station

 | Image: Station Station

 | Nor to Seele Owner's Name: Kichursh. (ASNA)

 | Image: Station Station

 | Image: Station Station

 | Norto Seale Norto Seale Owner's Name: Kichuish. Lashalia. Address: Dane: C. R. C. M. L. M.
 | Norto Scale Norto Scale Norto Scale Ownars Name: Comars Name: Carlon Address: Dane: Dane: Address: Dane: Address:


 | Nor to Seele Owner's Name:

 | Nor to Seele Owner's Name:
 | Nor to Seele Owner's Name:

 | Nor to Seele Owner's Name:
 | Not to Seale Owner's Name:

 | Not to Seale Owner's Name:
 | Nor to Seele Owner's Name: | Nor to Seele Owner's Name:
 | North Scale North Scale North Scale North Scale North Scale Owner's Name: Address: Name:
 | Norio Scele Norio Scele Norio Scele Ownar's Name:
 | Norroseie Owners Name: Mani | Norroseie Owners Name: Mani |
| 15 tuch
175 tuch
19 Saci | Norto Seele Norto Seele Owner's Name: Mand. Address: De.D.C.C. De.D.C.C. Phone: De.D.C.C.

 | Not to Seele Not to Seele Owner's Name:

 | Image: Station Notro Serie Ownar's Name:

 | Image: Station Notro Serie Ownar's Name:

 | Norto Seale Owners Name: Kichula Kand

 | Image: Station Notro Serie Ownar's Name:

 | Image: Station Notro Serie Ownar's Name:

 | Image: State Not to Seele Owner's Name:
 | Not to Seele Not to Seele Owner's Name:

 | Not to Seele Not to Seele Owner's Name: Kach, M.
KANAL Address: DERAGE DERAGE Address: DERAGE | Nor to Seele Owner's Name: K.C.M.M

 | Nor to Seele Owner's Name: K.C.W.M

 | Not to Seele Owner's Name: K.C.M.M
 | Not to Seele Owner's Name: K.C.M.M

 | Not to Seele Owner's Name: K.C.M.M
 | Not to Seele Owner's Name: K.C.M.M

 | Not to Seele Owner's Name:
 | Not to Seele Owner's Name:
 | Not to Scale Owner's Name:
 | Nor to Seele Owner's Name:

| I 5 tutin
I 75 tutin
I 75 tutin
I 9 Sati | Not to Scale Owner's Name:

 | Not to Scale Not to Scale Ownar's Name: C. C. C. M. J. M. M. J. M.

 | Not to Seele Not to Seele Owner's Name: Kichuish, Landi Address: Diago Address: Diago Address: Diago Address: Address:

 | Not to Seele Not to Seele Owner's Name: Kichuish, Landi Address: Diago Address: Diago Address: Diago Address: Address:

 | Instruction Notion Scale Owner's Name: Kichuish, Kashah. Instruction Instruction Instruction

 | Not to Seele Not to Seele Owner's Name: Kichuish, Landi Address: Diago Address: Diago Address: Diago Address: Address:

 | Not to Seele Not to Seele Owner's Name: Kichuish, Landi Address: Diago Address: Diago Address: Diago Address: Address:

 | Not to Seale Not to Seale Owner's Name:
 | Not to Scale Not to Scale Ownar's Name: C. C. C. M. J. M. M. J. M.

 | Not to Seele Owner's Name: Kich, M. K. ANNA Not to Seele Owner's Name: C. K. C. M. K. ANNA Address: D. C. M.
 | Nor to Scale Owner's Name:

 | Nor to Seele Owner's Name: Math. MANA. Nor to Seele Owner's Name: MANA. Address: De.0500 Phone: De.0500 Address: De.0500
 | Nor to Seale Owner's Name:

 | Nor to Seale Owner's Name:
 | Nor to Seale Owner's Name:

 | Nor to Seale Owner's Name:
 | Not to Seele Owner's Name:

 | Not to Seele Owner's Name:
 | Nor to Scale Owner's Name: | Nor to Scale Owner's Name:
 | Nor to Seele Owner's Name:
 | No Reference North Scale No Reference No No Reference No

| 15 tuch
175 tuch
19 Stel | Not to Seele Ownar's Name:

 | Image: State of the sector Not to Sector Owner's Name:

 | In the second

 | In the second

 | Nor to Seele Owner's Name: Kichurkh, KANIA

 | In the second

 | In the second

 | Image: Station State Owner's Name:
 | Image: State of the sector Not to Sector Owner's Name:

 | Not to Scale Not to Scale Not to Scale Ownar's Name: Address: Dens: Address: Dens: Phone: Dens: Access Report of Anthonia Access Report of Anthonia Access | Not to Seale
Not to Seale
Ownar's Name:

 | Nor to Seele Owner's Name:

 | Nor to Seele Owner's Name:
 | Nor to Seele Owner's Name:

 | Nor to Seele Owner's Name:
 | Nor to Seele Owner's Name:

 | Not to Seele Owner's Name:
 | Not to Seele Owner's Name:
 | Address: DEDMIT. MENN
 | Address:

 | Norto Scele Norto Scele Owner's Name: Markin, | Not to Scale Not to Scale Owner's Name: Markin,
 | Not to Scale Owner's Name: Matter State Address: | Not to Scale Owner's Name: Matter State Address:
 | Not to Scale Not to Scale Owner's Name: Markin, | Not to Scale Not to Scale Owner's Name: Markin, | Not to Scale Not to Scale Owner's Name: Markin,
 |
| 15 turn
15 turn
175 turn
19 Sach | Nor to Seele Owner's Name:

 | Not to Seale Not to Seale Owner's Name: C. R.C.M.M. (ANNA

 | Nor to Seale Owner's Name: K.K.M.M. (ANA)

 | Nor to Seale Owner's Name: K.K.M.M. (ANA)

 | Nor to Seale Owner's Name: K.C.M.M. (ANN)

 | Nor to Seale Owner's Name: K.K.M.M. (ANA)

 | Nor to Seale Owner's Name: K.K.M.M. (ANA)

 | Norto Scale Owner's Name: Kichur,M. (ANNA
 | Not to Seale Not to Seale Owner's Name: C. R.C.M.M. (ANNA


 | Not to Seele Owner's Name:

 | Not to Seele Owner's Name:
 | Not to Seele Owner's Name:

 | Not to Seele Owner's Name:
 | Not to Seele Owner's Name:

 | Not to Seale Ownar's Name:
 | Not to Seale Ownar's Name:
 | Nor to Scale Owner's Name:
 | Nor to Seele Owner's Name:
 | Nor to Seele Owner's Name: | Nor to Scale Nor to Scale Ownar's Name: Connar's Name: Address: D.C.B.A.M

 | Not to Scale Not to Scale Ownar's Name: C.R.C.M.M. (ANM) Address: D.D.C.C. Phone: D.D.C.C. Access Report of | Morroscele Owner's Name:
 | Actres: DEDAT. MENA., MANA | Actres: DEDAT. MENA., MANA
 | Morroscele Owner's Name: | Morroscele Owner's Name: | Morroscele Owner's Name:
 |
| 1 5 1 ULN
1 5 1 ULN
1 7 5 1 ULN
1 8 7 0 U | Nor to Scale
Ownar's Name:

 | Not to Scale Not to Scale Ownar's Name:

 | Image: Station Norto Scale Station Image: Station Norto Scale Ownar's Name:

 | Image: Station Norto Scale Station Image: Station Norto Scale Ownar's Name:

 | STATION STATION Ion to Scale Ownar's Name:

 | Image: Station Norto Scale Station Image: Station Norto Scale Ownar's Name:

 | Image: Station Norto Scale Station Image: Station Norto Scale Ownar's Name:

 | Image: Station Notro Scale Notro Scale Station Image: Station Notro Scale Ownar's Name:
 | Not to Scale Not to Scale Ownar's Name:

 | Not to Seele
Not to Seele
Owner's Name:
 | Nor to Seele
Owner's Name:

 | Nor to Seele
Nor to Seele
Owner's Name:
 | Not to Seele Owner's Name:

 | Not to Seele Owner's Name:

 | Not to Seele Owner's Name:
 | Not to Seele Owner's Name:
 | Not to Seele Not to Seele Owner's Name: MR.C.M.M

 | Not to Seele Not to Seele Owner's Name: MR.C.M.M
 | Not to Scale Owner's Name:
 | Nor to Scale Ownar's Name: | Nor to Scale Nor to Scale Nor to Scale Owner's Name:
 | Image: Control Scale North Scale North Scale Image: Control Scale Owner's Name:
 | Not to Scale Not to Scale Owner's Name: C. C
 | Not to Scale Not to Scale Ownar's Name: C. R. M.M | Not to Scale Not to Scale Ownar's Name: C. R. M.M
 | Not to Scale Not to Scale Owner's Name: C. C | Not to Scale Not to Scale Owner's Name: C. C | Not to Scale Not to Scale Owner's Name: C. C |
| 15 turn
15 turn
175 turn
19 Srot | Not to Seele
Not to Seele
Ownar's Name:

 | Not to Scale Not to Scale Not to Scale Ownar's Name: Comar's Name: Carlon Address: Dir.D.B.C. Address: Phone: Dir.D.B.C. Phone: Access Report of Americable

 | Norto Seale Norto Seale Owner's Name:

 | Norto Seale Norto Seale Owner's Name:

 | Nor to Seale Nor to Seale Owner's Name: STATION Nor to Seale Owner's Name: C. C. N. C. M.

 | Norto Scale Norto Scale Owner's Name:

 | Norto Scale Norto Scale Owner's Name:

 | Norto Seale Norto Seale Ownar's Name: Comer's Name: Address: Date:
 | Not to Scale Not to Scale Not to Scale Ownar's Name: Comar's Name: Carlon Address: Dir.D.B.C. Address: Phone: Dir.D.B.C. Phone: Access Report of Americable

 | Not to Scale
Not to Scale
Ownar's Name:
 | Not to Seale
Owner's Name:

 | Nor to Seele
Owner's Name:

 | Nor to Seele Owner's Name:
 | Nor to Seele Owner's Name:

 | Nor to Seele Owner's Name:
 | Nor to Seele Owner's Name:

 | Not to Seale Not to Seale Owner's Name: C.C.M.M
 | Not to Seale Not to Seale Owner's Name: C.C.M.M
 | Not to Seele Not to Seele Owner's Name: C. R.C.M.N
 | Address:


 | Not to Scale Owner's Name: March Mand | Not to Scale Owner's Name: March Mand
 | Not to Scale Not to Scale Owner's Name: Markin, | Not to Scale Not to Scale Owner's Name: Markin, | Not to Scale Not to Scale Owner's Name: Markin, |
| 1 35 tues
1 5 tues
1 7 tues
1 7 S tues
1 8 S tues | Not to Scele Ownar's Name:

 | Not to Scale Not to Scale Owner's Name: C. R.C.W.M. (ANNA

 | Norto Scale Owner's Name: Kichur,M., KANA

 | Norto Scale Owner's Name: Kichur,M., KANA

 | Nor to Seele Owner's Name: Kichwith, KANA

 | Norto Scale Owner's Name: Kichur,M., KANA

 | Norto Scale Owner's Name: Kichur,M., KANA

 | Norto Scale Owner's Name: Kinukh, KANA Ion to Scale Owner's Name: C. R.C.M.A. KANA Address: De.D.D.C. Phone: Phone: Phone: Access
 | Not to Scale Not to Scale Owner's Name: C. R.C.W.M. (ANNA

 | Not to Scale Not to Scale Not to Scale Ownar's Name: Address: Dend: Address: Dend: Phone: Dend:
 | Not to Scale Ownar's Name:

 | Nor to Scale
Ownar's Name:
 | Nor to Seale
Owner's Name:

 | Nor to Seale
Owner's Name:

 | Nor to Seale
Owner's Name:
 | Nor to Seale
Owner's Name:
 | Not to Scale Owner's Name:

 | Not to Scale Owner's Name:
 | Nor to Seele Nor to Seele Owner's Name: McKuulin, LANIA
 | Nor to Seele Nor to Seele Owner's Name: McKinuithi, LANIA | Norto Scale Norto Scale Ownar's Name: Connar's Name: Address: D.C.R. Phone: D.C.R. Access Report of Man Access
 | Image: Second
 | Not to Scale Not to Scale Ownar's Name: Markin,
 | Not to Scele Not to Scele Owner's Name: Markin, | Not to Scale Owner's Name: Markin,
 | Not to Scale Owner's Name: Markin, | Not to Scele Not to Scele Owner's Name: Markin,
 | Not to Scele Not to Scele Owner's Name: Markin, | Not to Scele Not to Scele Owner's Name: Markin, |
| 15 tuen
15 tuen
175 tuen | Nor to Scale Owner's Name:

 | Not to Scale Ownar's Name:

 | Nor to Seale Nor to Seale Nor to Seale Owner's Name:

 | Nor to Seale Nor to Seale Nor to Seale Owner's Name:

 | Nor to Scale Nor to Scale Owner's Name: Kkou, M

 | Nor to Seale Nor to Seale Nor to Seale Owner's Name:

 | Nor to Seale Nor to Seale Nor to Seale Owner's Name:

 | Nor to Seale Nor to Seale Owner's Name: C.R.M.M. (ANR)
 | Not to Scale Ownar's Name:

 | Not to Scale Owner's Name: | Nor to Seele Owner's Name:

 | Not to Seele Owner's Name:











 | Not to Seale Not to Seale Ownar's Name: Constraints Address: Catholic
 | Not to Scale
Not to Scale
Ownar's Name:

 | Not to Scale
Not to Scale
Ownar's Name:
 | Nor to Scale Ownar's Name:

 | Nor to Seele Owner's Name:

 | Not to Seele Owner's Name:
 | Not to Seele Owner's Name:

 | Not to Seele Owner's Name:
 | Not to Seele Owner's Name:

 | Not to Seele Owner's Name:
 | Not to Seele Owner's Name:
 | Not to Scale Owner's Name:
 | Not to Scale Owner's Name:
 | Nor to Scale Owner's Name: | Interview Name: Mckinwith MANA Address: Decomers Decomers Address: Address:


| 1 5 turn
1 5 turn
1 75 turn
1 75 turn
1 9 Stel | Not to Scele Ownar's Name:

 | Nor to Scale Nor to Scale Station Ownar's Name: Mc/uc/MNA Station Address:

 | STATION Norto Scale Owner's Name: MchurM. (ANN) Address: Dir.D.0.000 Phone: Phone: Access Report of Jun 119mes found exitable funewitable.





 | Not to Seele Not to Seele St ATION Not to Seele Owner's Name:
 | Nor to Scale Nor to Scale Station Ownar's Name: Mc/uc/MNA Station Address:

 | Not to Scale
Not to Scale
Ownar's Name: | Not to Scale Ownar's Name:

 | Nor to Scale
Ownar's Name:

 | Not to Seele
Ownar's Name:
 | Not to Seele
Ownar's Name:

 | Not to Seele
Ownar's Name:
 | Not to Seele
Ownar's Name:

 | Not to Seale Owner's Name:
 | Not to Seale Owner's Name:
 | Not to Seele Not to Seele Owner's Name: Martin, MANA. Address: Display: Phone: Display: Access Report of Jan. Access Report of Jan.
 | Not to Scale Not to Scale Owner's Name: Markin, MANA. Address: Display: Phone: Display: Access Report of June 199. Access Report of June 199.

| 1 5 1 URN
1 5 1 URN
1 5 1 URN
1 75 1 URN
1 75 1 URN
1 75 1 URN
1 9 5701 | Not to Scale
Not to Scale
Ownar's Name:

 | Not to Seale Not to Seale Owner's Name: Mc/um/M. (ANNA

 | STATION Not to Seale Not to Seale Not to Seale Owner's Name:

 | STATION Not to Seale Not to Seale Not to Seale Owner's Name:

 | STATION Nor to Seale Owner's Name:

 | STATION Not to Seale Not to Seale Not to Seale Owner's Name:

 | STATION Not to Seale Not to Seale Not to Seale Owner's Name:

 | Norto Scale Norto Scale Owner's Name: McANA
 | Not to Seale Not to Seale Owner's Name: Mc/um/M. (ANNA

 | Not to Scale Not to Scale Ownar's Name: | Not to Scele Ownar's Name:

 | Not to Scale Ownar's Name:

 | Nor to Scale
Ownar's Name:
 | Nor to Scale
Ownar's Name:

 | Nor to Scale
Ownar's Name:
 | Nor to Scale
Ownar's Name:

 | Not to Scale Owner's Name:
 | Not to Scale Owner's Name:
 | Nor to Scale Nor to Scale Owner's Name: McKiwith, LANIA
 | Nor to Seele Nor to Seele Owner's Name: McKinuth, LANN. Address: Dickin. Phone: Address: Access Report of M. M. 19
 | Norto Scale Norto Scale Owner's Name: Conner's Name: Address: D.C.G.C. Phone: Access Report of Mark 19. | Image: Second
 | Not to Scale Not to Scale Ownar's Name: Mot to Scale









































































































































































































 |
| Address: |

 |

 | STATION STATION

 | STATION STATION

 | STATION Station

 | STATION STATION

 | STATION STATION

 |
 |

 | |

 |

 | Not to Scele
 | Not to Scele

 | Not to Scele
 | Not to Scele

 | Not to Stale
 | Not to Stale
 | Not to Scale
 | Not to Scale
 | Not to Scale | Not to Scale

 | Not to Scale | Notro Seale
 | Not to Scale | Not to Scale
 | Notro Seale | Notro Seale | Notro Seale
 |
| Address: | 014110N

 |

 | STATION Scale Voto Sca

 | STATION Scale Voto Sca

 | STATION State Not to Scale V




 |

 | 01A110N
 | Not to Scale

 | Not to Scale V.


 |

 |
 | |
 |
 | Notro Scale V.
 | Not to Scale
 | Not to Scale | Not to Scale
 | Not to Scale | Not to Scale
 | Not to Scale | Not to Scale |
| Address | Not to State

 | Station State

 | STATION State

 | SIALION

 | STATION

 | STATION

 | STATION

 | STATION

 | STATION

 | SIAIION
 | SIALION

 |
 |

 |

 |
 |

 |
 |
 |

 |
 |
 |
 | |

 | |
 | |
 | | |
 |
| Not to State Not to State Ownar's N Address: Phone: < | SIALION

 | SIALION

 | STATION

 | STATION

 | STATION

 | STATION

 | STATION

 | STATION
 | SIALION

 | SIATION
 |

 |

 |
 |

 |
 |

 |
 |
 |
 |
 | |

 | |
 | |
 | | |
 |
| North Scele North Scele Address: - Phone: - Pate - Pate - Pate - Pate - Pate - |

 |

 |

 |

 | STATION STATION

 |

 |

 |
 |

 |
 |

 |

 |
 |

 |
 |

 |
 |
 |
 |
 | |

 | |
 | |
 | | |
 |



































































































































































































































































 |

TS1615 | Print Date: 31/05/2022 15:28 | No Of Pages: 6 | Property of DFSI – Spatial Services

. . .