CENTRAL MAPPING AUTHORITY — GEODETIC SURVEY OF N.S.W.

GEODETIC STATION RECONNAISSANCE and MAINTENANCE REPORT

STATION: CROMIE	No.: 1698
MAP SHEET SCALE 1:250 000: BATHURST	
INSPECTED BY: A. GARSIDE	DATE: 10-8-81
AUTHORITY: CMA	FIELD BOOK: 1986

Description: *Note: Cross out word or words which do not apply*

1. Cleared by lanes bearing.....from Trig. Mast
2. Mast & Vanes have been painted white & black respectively.
3. The station/pillar was unpiled/not unpiled/constructed on.....19....., dimensions now being:

   Description of mark.....should be explicit, e.g., S/Steel Pillar Plate, Steel plug, Brass plug, Bolt, G.I. Pipe

   Height of mark.....m. above/below rock/concrete; Mark is.....m. above/below G.L.

   Height of Top Vanes to Top Mark/Pillar plate .....m. Diameter of Vanes (vertical).....m.

   Height of Cairn.....m. Diameter of Cairn.....m. Name Plate found/not found/placed.

   Length of Mast .....m. (approximate if not unpiled)
4. A.....set in conc/rock has been placed/found, bearing .....°M from Mast/Plug/Pillar
5. A.....set in conc/rock has been placed/found, bearing.....°M from Mast/Plug/Pillar
6. A.....set in conc/rock has been placed/found, bearing.....°M from Mast/Plug/Pillar
7. A.....set in conc/rock has been placed/found, bearing.....°M from Mast/Plug/Pillar
8. Action required: No marks found Station of little value

STANDPOINT: Mark	Direction	Horiz. Distance	Height Difference	STANDPOINT: Mark	Direction	Horiz. Distance	Height Difference
			above/below standpt.				above/below standpt.
			above/below standpt.				above/below standpt.
			above/below standpt.				above/below standpt.
			above/below standpt.				above/below standpt.
			above/below standpt.				above/below standpt.
			above/below standpt.				above/below standpt.
			above/below standpt.				above/below standpt.

Prepared by: A. Garside 27/8/81 Checked: Noted on U.T.M. Card

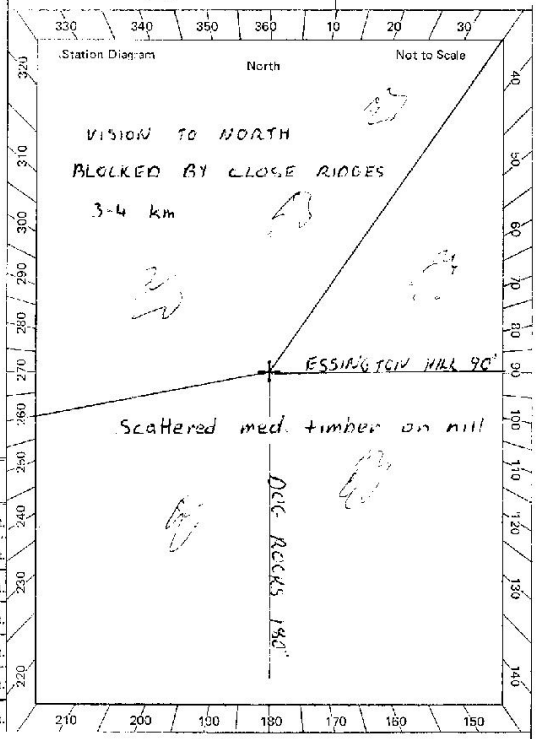

Checked

ST 2733—1

TS1698 | Print Date: 31/05/2022 15:29 | No Of Pages: 2 | Property of DFSI – Spatial Services

TS1698 | Print Date: 31/05/2022 15:29 | No Of Pages: 2 | Property of DFSI – Spatial Services

St 2733–2 D. West, Government Printer

STATION CROMIE TS 1698

Beacon Diagram — Not to Scale

Owner's Name: T N LAWSON

Address: BRADLEYS FLAT PAST LO
5 BAY ST DOUBLE BAY

~~Phone:~~ GEN MANAGER W LOCKIE

~~Current Occupant:~~ MANAGER DAVE PEARCE

Address: BLACK SPRINGS

Phone: 358133

ACCESS 10-8-1981

Access Report of 10/8/1981 ~~was found suitable/unsuitable.~~

0·0 ROCKLEY P.O. TAKE ROAD TO "BURRAGA 35, OBERON 34 BUDDEN ST."
1·25 TURN LEFT INTO GRAVEL ROAD "OBERON VIA CHARLTON 32"
2·25 PASS GATE ON RIGHT TO OCCUPANT'S HOUSE
2·35 CAUSEWAY
4·4 PARK TRUCK AT CORNER NEAR "WILDLIFE REFUGE" SIGN
5 MINUTE WALK UP SPUR OVER FENCE ON RIGHT.

NOTE POSSIBLE TO DRIVE TO TRIG OBTAIN KEY TO LOCKED GATE AT QUARRY FROM HOUSE ON TRACK AT 2·25.

This section to be completed by officer constructing pillar.

Original station mark found/not found.

Description of mark: .....

Original beacon found/not found.

Description of beacon: .....

Height Top of Vanes to Top Mark .....m.

Height of mark.....m. above/below rock/conc .....m. above/below G.L.

Diameter of Vanes .....m. Height of Cairn .....m.

Original Beacon has/has not been destroyed by me.

Date	Record of Station