CENTRAL MAPPING AUTHORITY

Department of Lands

Trigonometrical Survey of N.S.W.

RECONNAISSANCE and MAINTENANCE REPORT

STATION JACOB TS 2578

Co: Hume | Ph: Thugga

Map Sheet: Holbrook No: 8326-N

Inspected by G. Hanna | Date: 12/10/76

Authority | Field Book:

Beacon Diagram Not to Scale

This Trig. Station has been:- *Note: Cross out word or words which do not apply*

1. Completely cleared to permit 360° vision to surrounding Trigs.
2. Cleared by lanes bearing..... from Trig. Mast
3. Trig. Mast & Vanes have been painted white & black respectively.
4. The Trig. was unpiled/not unpiled, dimensions now being: Original Station Mark found / not found

   Description of mark..... should be explicit, e.g. Steel plug, Brass plug, Bolt, G.I. Pipe

   Height of mark.....m above/below rock/concrete .....m above/below G.L.

   Height of Top Vanes to Top Mark..... m. Diameter of Vanes (vertical).....m.

   Height of Cairn.....m. Diameter of Cairn.....m.

   Length of Mast.....m. (approximate if not unpiled)
5. A.....set in conc/rock has been placed.....m. bearing.....°M from Trig. Mast
6. A.....set in conc/soil has been placed.....m. bearing.....°M from Trig. Mast
7. A.....set in conc/soil has been placed.....m. bearing.....°M from Trig. Mast
8. A.....set in conc/rock has been placed.....m. bearing.....°M from Trig. Mast
9. Connection.....to.....: ..... m. bearing.....°M
10. Connection.....to.....: ..... m. bearing.....°M
11. Connection.....to.....: ..... m. bearing.....°M
12. Connection.....to.....: ..... m. bearing.....°M
13. Diff. Ht. ..... is..... m. above/below .....
14. Diff. Ht. ..... is..... m. above/below .....
15. Diff. Ht. ..... is..... m. above/below .....
16. Diff. Ht. ..... is..... m. above/below .....

NOT APPLICABLE

Date	Record of Station

Prepared by: *Checked:* *Noted on U.T.M. Card* *Checked*

TS2578 | Print Date: 31/05/2022 15:59 | No Of Pages: 4 | Property of DFSI – Spatial Services

TS2578 | Print Date: 31/05/2022 15:59 | No Of Pages: 4 | Property of DFSI – Spatial Services

STATION JACOB TS 2578

Station Diagram — Not to Scale

North

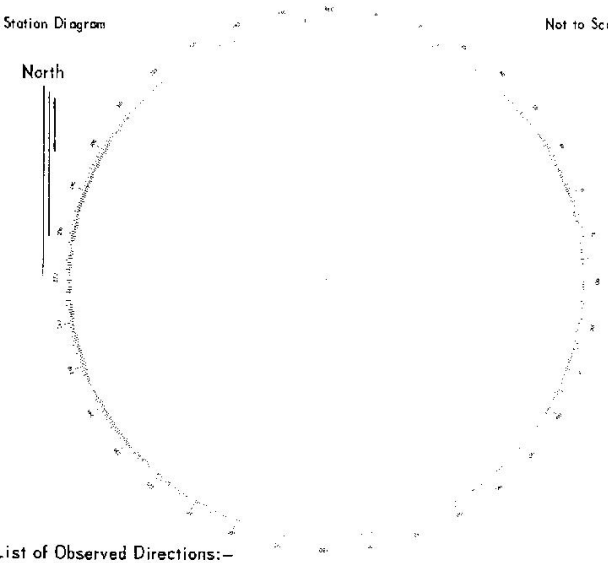

List of Observed Directions:–

Standpoint:		Standpoint:	
Station	Direction	Station	Direction
Station	Direction	Station	Direction

Owners Name.....

Address.....

.....

Current Occupant.....

Address.....

.....

Access 12/10/1976

Diagram not to scale
Station mark not found

Light clearing required to permit 360° Vision
Some hills 2–3 Km to the West

For access see Holbrook 1:25 000
8326 – 1 – S

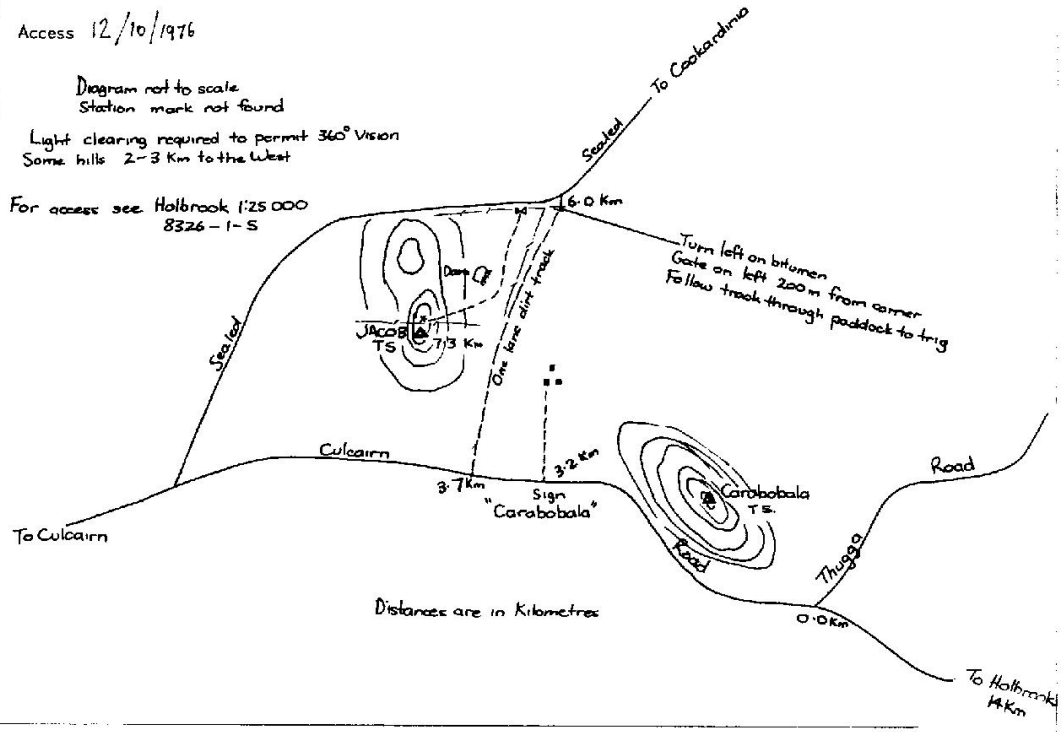

CENTRAL MAPPING AUTHORITY

GEODETIC SURVEY OF N.S.W.

GEODETIC STATION RECONNAISSANCE and MAINTENANCE REPORT

STATION: JACOB	No.: 2578
MAP SHEETS SCALE 1:250 000 WAGGA WAGGA	SCALE 1:100 000 HOLBROOK
INSPECTED BY: J. Sutton	DATE: 19 Nov 1988
AUTHORITY: CMA	FIELD BOOK: –

Description: *Note: Cross out word or words which do not apply*

1. Cleared by lanes bearing..... from Trig. Mast
2. Mast & Vanes have been painted white & black respectively.
3. The station/pillar was unpiled/not unpiled/constructed on.....19....., dimensions now being:

   Description of mark.....should be explicit, e.g., S/Steel Pillar Plate, Steel plug, Brass plug, Bolt, G.I. Pipe

   Height of mark.....m. above/below rock/concrete; Mark is.....m. above/below G.L.

   Height of Top Vanes to Top Mark/Pillar plate .....m. Diameter of Vanes (vertical).....m.

   Height of Cairn.....m. Diameter of Cairn.....m. Name Plate found/not found/placed.

   Length of Mast .....m. (approximate if not unpiled)
4. A.....set in conc/rock has been placed/found, bearing.....°M from Mast/Plug/Pillar
5. A.....set in conc/rock has been placed/found, bearing.....°M from Mast/Plug/Pillar
6. A.....set in conc/rock has been placed/found, bearing.....°M from Mast/Plug/Pillar
7. A.....set in conc/rock has been placed/found, bearing.....°M from Mast/Plug/Pillar
8. Action required:.....

NOT APPLICABLE

STANDPOINT:

Mark	Direction	Horiz. Distance	Height Difference
			above/below standpt.
			above/below standpt.
STANDPOINT:

Mark	Direction	Horiz. Distance	Height Difference
			above/below standpt.
			above/below standpt.
Station Diagram — North — Not to Scale

Station mark not found.

Prepared by: J Sutton 2.2.89 Checked: Noted on U.T.M. Card Checked

TS2578 | Print Date: 31/05/2022 15:59 | No Of Pages: 4 | Property of DFSI – Spatial Services

TS2578 | Print Date: 31/05/2022 15:59 | No Of Pages: 4 | Property of DFSI – Spatial Services

Bt 2733—2 C. West, Government Printer

STATION JACOB TS 2578

Beacon Diagram Not to Scale

Owner's Name Graham Schulz
Address "Boorook" Morven 2660
Phone (060) 365205

Current Occupant: Les Salter
Address "Woorinyan Morven 2660
Phone (060) 365242

ACCESS: 19 - Nov 1988

Access Report of 12/10/1976 was found ~~suitable~~/unsuitable.

Access is now through "Woorinyan" homestead as all gates are now kept locked. See owner or occupier first.

This section to be completed by officer constructing pillar.

Original station mark found/not found.

Description of mark: .....

Original beacon found/not found.

Description of beacon: .....

Height Top of Vanes to Top Mark.....m.

Height of mark.....m. above/below rock/conc.....m. above/below G.L.

Diameter of Vanes .....m. Height of Cairn .....m.

Original Beacon has/has not been destroyed by me.

Date	Record of Station