CENTRAL MAPPING AUTHORITY

GEODETIC SURVEY OF N.S.W.

GEODETIC STATION RECONNAISSANCE and MAINTENANCE REPORT

STATION: NEVILLE	No.: 3366
MAP SHEET SCALE 1:250 000 BATHURST	
INSPECTED BY: A. GARSIDE	DATE: 19-8-81
AUTHORITY: C.M.A.	FIELD BOOK: 1996

Description: *Note: Cross out word or words which do not apply*

1. Cleared by lanes bearing STATION SURROUNDED BY CLOSE RIDGES from Trig. Mast
2. Mast & Vanes have been painted white & black respectively.
3. The station/pillar was unpiled/not unpiled/constructed on.....19....., dimensions now being:

   Description of mark.....should be explicit, e.g., S/Steel Pillar Plate, Steel plug, Brass plug, Bolt, G.I. Pipe

   Height of mark.....m. above/below rock/concrete; Mark is.....m. above/below G.L.

   NO SIGN OF ANY MARKS

   Height of Top Vanes to Top Mark/Pillar plate .....m. Diameter of Vanes (vertical).....m.

   Height of Cairn.....m. Diameter of Cairn.....m. Name Plate found/not found/placed.

   Length of Mast .....m. (approximate if not unpiled)
4. A.....set in conc/rock has been placed/found, bearing.....°M from Mast/Plug/Pillar
5. A.....set in conc/rock has been placed/found, bearing.....°M from Mast/Plug/Pillar
6. A.....set in conc/rock has been placed/found, bearing.....°M from Mast/Plug/Pillar
7. A.....set in conc/rock has been placed/found, bearing.....°M from Mast/Plug/Pillar
8. Action required: OK TO BUILD PILLAR STATION IS USELESS

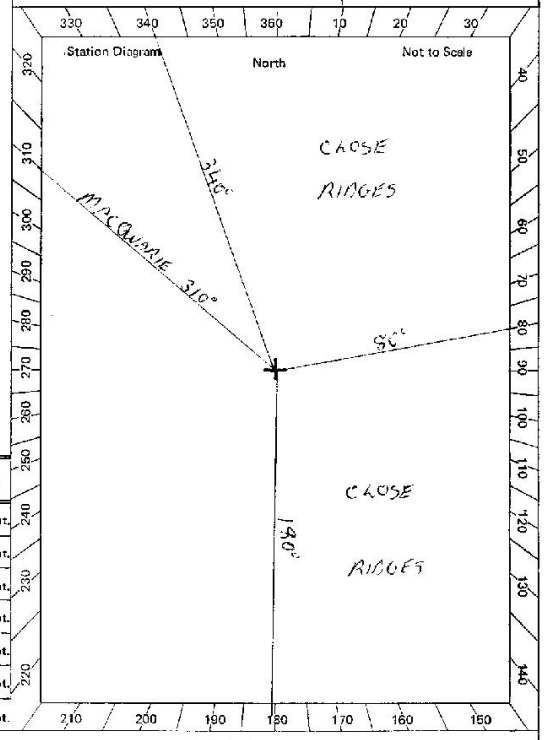

STANDPOINT:

Mark	Direction	Horiz. Distance	Height Difference
			above/below standpt.
			above/below standpt.
			above/below standpt.
			above/below standpt.
			above/below standpt.
			above/below standpt.
			above/below standpt.

STANDPOINT:

Mark	Direction	Horiz. Distance	Height Difference
			above/below standpt.
			above/below standpt.
			above/below standpt.
			above/below standpt.
			above/below standpt.
			above/below standpt.
			above/below standpt.

Prepared by: [signature] 15/10/81 *Checked:* *Noted on U.T.M. Card* *Checked*

St 2733–1

TS3366 | Print Date: 31/05/2022 16:14 | No Of Pages: 2 | Property of DFSI – Spatial Services

St 2733–2 D. West, Government Printer

STATION NEVILLE TS 3366

Beacon Diagram — Not to Scale

Owner's Name: K. C. RADBURN

Address: KERRELL PARTNERSHIP
NEVILLE

Phone: NEVILLE 44

Current Occupant: .....

Address: .....

Phone: .....

ACCESS

Access Report of 19/8/1981 was found suitable/unsuitable.

Km	Feature
0·0	NEVILLE P.O. TAKE ROAD ON RIGHT "TRUNKEY 24 + ABERCROMBIE CAVES"
1·2	TURN LEFT OVER BRIDGE AND THEN RIGHT "TRUNKEY 22" OWNER LIVES STRAIGHT AHEAD "BARRY 9" IN FIRST HOUSE ON RHS
2·7	THROUGH DOUBLE IRON GATES ON LEFT FOLLOW TRACK UP FENCE.
3·0	TAKE TRACK AROUND TO RIGHT. AT FENCE CORNER
3·9	NEVILLE GS AT TOP OF LANDING GROUND

This section to be completed by officer constructing pillar.

Original station mark found/not found.

Description of mark: .....

Original beacon found/not found.

Description of beacon: .....

Height Top of Vanes to Top Mark.....m.

Height of mark.....m. above/below rock/conc.....m. above/below G.L.

Diameter of Vanes .....m. Height of Cairn .....m.

Original Beacon has/has not been destroyed by me.

Date	Record of Station

TS3366 | Print Date: 31/05/2022 16:14 | No Of Pages: 2 | Property of DFSI – Spatial Services