CENTRAL MAPPING AUTHORITY

GEODETIC SURVEY OF N.S.W.

GEODETIC STATION RECONNAISSANCE and MAINTENANCE REPORT

STATION: NM / C / 84	No.: 3518
MAP SHEET SCALE 1:250 000 WALGETT	
INSPECTED BY: D. FREDRIKSEN	DATE: 10/7/79
AUTHORITY: C.M.A.	FIELD BOOK:

Access and Locality Sketch:

Particulars of station marking and beacon:

STATION MARK. ½" diameter copper tube in concrete block which is reinforced with a steel picket set directly below the copper tube. Station number is marked on the concrete block.

BEACON. Nil.

REFERENCE MARKS. Three ½" copper tubes in concrete blocks which are re-in - forced with steel pickets set below the copper tubes. One steel witness post and one red painted blaze on a tree.

ACCESS. NM/C/84 is sited at a very slight bend in the Walgett - Brewarrina road 32.7 miles west of Walgett. It is very close against the southern edge of the road to see along the cleared line of the road east for 5½ miles, and west across the tops of the trees for about 9½ miles to a low hill. A 30' tower was needed for the observations and measurements. A 12 foot diameter trench was dug around indicated R.M. owing to the closeness of the station mark to the road.

7. A.....set in conc/rock has been placed/found, bearing.....

8. Action required:.....

STANDPOINT:

Mark	Direction	Horiz. Distance	Height Difference	Mark	Direction	Horiz. Distance	Height Difference
			above / below standpt.				above / below standpt.
			above / below standpt.				above / below standpt.
Photo Identification:

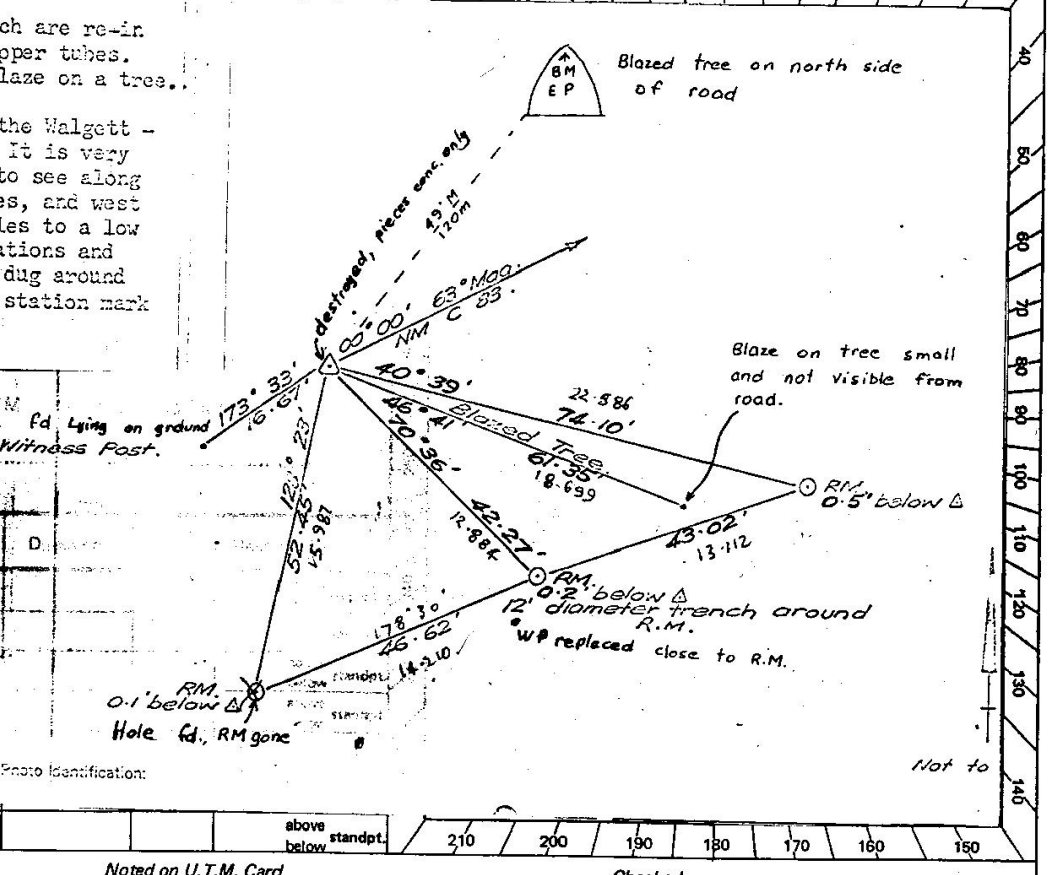

Prepared by: D. Fredriksen 25/10/79 Checked:

Noted on U.T.M. Card

Checked

Form 2733–1

TS3518 | Print Date: 31/05/2022 16:16 | No Of Pages: 2 | Property of DFSI – Spatial Services

St 2733—2 D. West, Government Printer

STATION NM/C/84 TS 3518

Beacon Diagram — Not to Scale

Owner's Name: .....

Address: .....

.....

Phone: .....

Current Occupant: .....

Address: .....

.....

Phone: .....

ACCESS

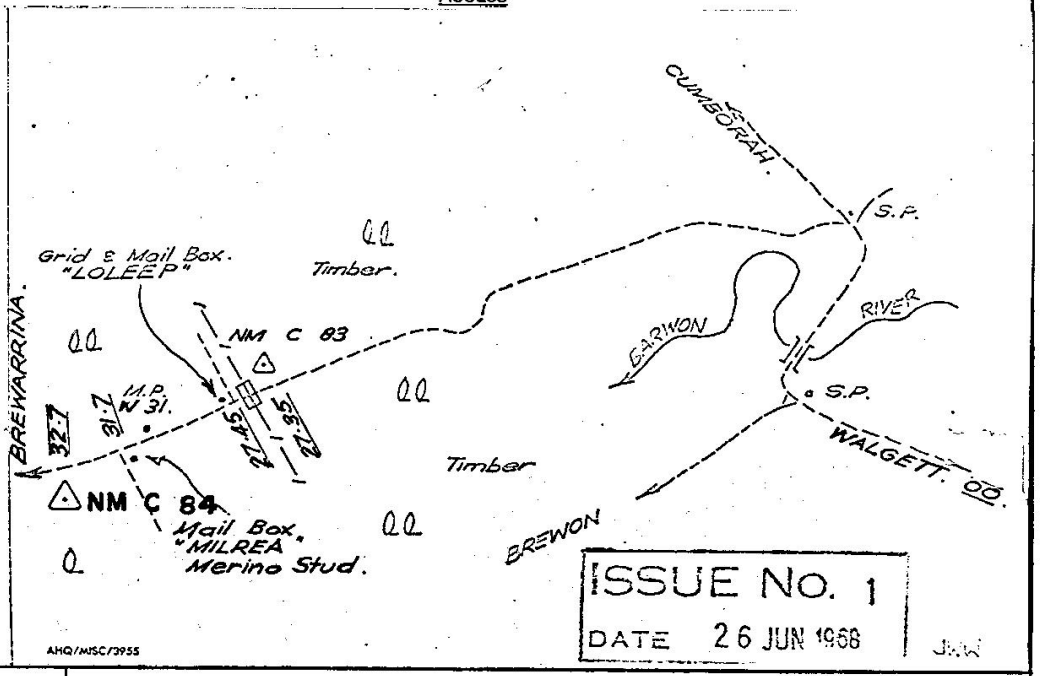

This section to be completed by officer constructing pillar.

Original station mark found/not found.

Description of mark: .....

Original beacon found/not found.

Description of beacon: .....

Height Top of Vanes to Top Mark.....m.

Height of mark.....m. above/below rock/conc.....m. above/below G.L.

Diameter of Vanes .....m. Height of Cairn .....m.

Original Beacon has/has not been destroyed by me.

Date	Record of Station

TS3518 | Print Date: 31/05/2022 16:16 | No Of Pages: 2 | Property of DFSI – Spatial Services